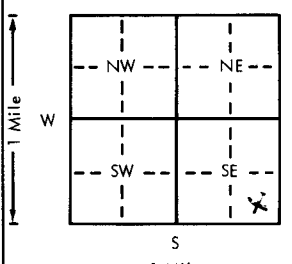
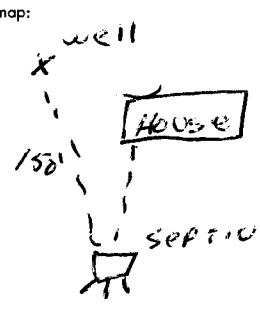


USE TYPEWRITER OR BALL
POINT PEN-PRESS FIRMLY,
PRINT CLEARLY.

WATER WELL RECORD
KSA 82a-1201-1215

Kansas Department of Health and
Environment-Division of Environment
(Water well Contractors)
Topeka, Kansas 66620

LOT # 79

1. Location of well:		County Geary	Fraction SE 1/4 SE 1/4 SE 1/4	Section number 32	Township number T 10 S	Range number R 5 E/W
2. Distance and direction from nearest town or city: 2 SE OF			3. Owner of well: RICHARD ROCKFUS			
Street address of well location if in city: MILFORD			R.R. or street: RFD3			
			City, state, zip code: JUNCTION CITY			
4. Locate with "X" in section below:		Sketch map:		6. Bore hole dia. 8 in. Completion date 8-30-77		
				Well depth 160 ft.		
5. Type and color of material		From	To	7. Cable tool <input checked="" type="checkbox"/> Rotary <input type="checkbox"/> Driven <input type="checkbox"/> Dug <input type="checkbox"/> Hollow rod <input type="checkbox"/> Jetted <input type="checkbox"/> Bored <input type="checkbox"/> Reverse rotary		
Top Soil		0	3	8. Use: <input checked="" type="checkbox"/> Domestic <input type="checkbox"/> Public supply <input type="checkbox"/> Industry <input type="checkbox"/> Irrigation <input type="checkbox"/> Air conditioning <input type="checkbox"/> Stock <input type="checkbox"/> Lawn <input type="checkbox"/> Oil field water <input type="checkbox"/> Other		
FINE SILT		3	20	9. Casing: Material PVC Height: Above or below		
Clay, BROWN		20	35	Threading: Welded Surface 24 in.		
Grey Limestone, FLINTY		35	95	RMP: PVC 42 Weight 255 lbs./ft.		
Shale, Grey, BIK.		95	107	Dia. 5 in. to 160 ft. depth Wall Thickness: inches or		
Limestone, Shale, FLINTY		107	131	Dia. 5 in. to 160 ft. depth gage No. 258		
Limestone, yellow, loose		131	134	10. Screen: Manufacturer's name PUMPCO MPT		
Shale, BIK, Limestone, Grey		134	160	Type PVC Dia. 5		
				Sieve/gauze 20 Length 20		
				Set between 120 ft. and 140 ft.		
				Gravel pack? <input checked="" type="checkbox"/> Size range of material 10-30/100		
				11. Static water level: 130 ft. below land surface Date 8-30-77		
				12. Pumping level below land surfaces:		
				ft. after hrs. pumping g.p.m.		
				ft. after hrs. pumping g.p.m.		
				Estimated maximum yield 20 g.p.m.		
				13. Water sample submitted: mo./day/yr.		
				Yes <input checked="" type="checkbox"/> No <input type="checkbox"/> Date		
				14. Well head completion: CAP		
				Pitless adapter 24 inches above grade		
				15. Well grouted? <input checked="" type="checkbox"/>		
				With: <input checked="" type="checkbox"/> Neat cement <input type="checkbox"/> Bentonite <input type="checkbox"/> Concrete		
				Depth: From 0 ft. to 10 ft.		
				16. Nearest source of possible contamination:		
				ft. 150 Direction S Type SEPTIC		
				Well disinfected upon completion? <input checked="" type="checkbox"/> Yes <input type="checkbox"/> No		
				17. Pump: <input checked="" type="checkbox"/> Not installed		
				Manufacturer's name		
				Model number HP Volts		
				Length of drop pipe ft. capacity g.p.m.		
				Type:		
				<input type="checkbox"/> Submersible <input type="checkbox"/> Turbine		
				<input type="checkbox"/> Jet <input type="checkbox"/> Reciprocating		
				<input type="checkbox"/> Centrifugal <input type="checkbox"/> Other		
18. Elevation:		19. Remarks:		20. Water well contractor's certification:		
Topography: <input checked="" type="checkbox"/> Hill <input type="checkbox"/> Slope <input type="checkbox"/> Upland <input type="checkbox"/> Valley		OWNER TO INSTALL SLAB		This well was drilled under my jurisdiction and this report is true to the best of my knowledge and belief.		
				Business name STRADER DAIG Co License No. 183		
				Address HOUSTON, KS		
				Signed Dale Strader Date 8-27-77		
				Authorized representative		

Forward the white, blue and pink copies to the Department of Health and Environment

Form WWC-5