

County: Geary Fraction SW SW SW Sec. 33 T 10 S R 5 (E/W)

CORRECTION(S) TO WATER WELL COMPLETION RECORD (WWC-5)
(to rectify lacking or incorrect information)

Owner: U. S. Army

Location was listed as:

Location changed to:

Section-Township-Range: _____

Fraction (1/4 1/4 1/4): _____

Other changes: Initial statements: Riley County

Changed to: Geary County

Comments: _____

Verification method: Legal description, position on plat map, and mapping tool on KGS website.


Submitted by: _____ initials: DRJ date: 10/3/2012
to: Kansas Geological Survey, Data Resources Library, 1930 Constant Ave., Lawrence, KS 66047-3726
to: Kansas Dept of Health & Environment, Bureau of Water, 1000 SW Jackson, Suite 420, Topeka, KS 66612-1367.

1 LOCATION OF WATER WELL: County: Riley Fraction SW 1/4 SW 1/4 Section Number 33 Township Number T 10 S Range Number R 5 E

Distance and direction from nearest town or city street address of well if located within city? OBOD MW2

2 WATER WELL OWNER: U.S. Army RR#, St. Address, Box #: DEH City, State, ZIP Code: Ft Riley Ks 66442 Board of Agriculture, Division of Water Resource Application Number:

3 LOCATE WELL'S LOCATION WITH AN "X" IN SECTION BOX: 4 DEPTH OF COMPLETED WELL: 72 ft. ELEVATION: WELL'S STATIC WATER LEVEL: 99.9 ft. below land surface

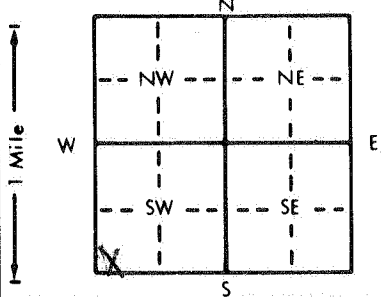

Pump test data: Well water was ... Est. Yield ... gpm: Well water was ... Bore Hole Diameter: 6 in. to 51 in. WELL WATER TO BE USED AS: 10 Monitoring well

5 TYPE OF BLANK CASING USED: 1 Steel, 2 PVC, 3 RMP (SR), 4 ABS, 5 Wrought iron, 6 Asbestos-Cement, 7 Fiberglass, 8 Concrete tile, 9 Other, 10 Asbestos-cement, 11 Other, 12 None used

Blank casing diameter: 2 in. to 57 ft. Dia. Casing height above land surface: 30 in., weight ... lbs./ft. Wall thickness or gauge No. ...

TYPE OF SCREEN OR PERFORATION MATERIAL: 1 Steel, 2 Brass, 3 Stainless steel, 4 Galvanized steel, 5 Fiberglass, 6 Concrete tile, 7 PVC, 8 RMP (SR), 9 ABS, 10 Asbestos-cement, 11 Other, 12 None used

SCREEN OR PERFORATION OPENINGS ARE: 1 Continuous slot, 2 Louvered shutter, 3 Mill slot, 4 Key punched, 5 Gauzed wrapped, 6 Wire wrapped, 7 Torch cut, 8 Saw cut, 9 Drilled holes, 10 Other, 11 None

SCREEN-PERFORATED INTERVALS: From 57 ft. to 72 ft. GRAVEL PACK INTERVALS: From 55 ft. to 72 ft.

6 GROUT MATERIAL: 1 Neat cement, 2 Cement grout, 3 Bentonite, 4 Other Grout Intervals: From 0 ft. to 55 ft.

What is the nearest source of possible contamination: 1 Septic tank, 2 Sewer lines, 3 Watertight sewer lines, 4 Lateral lines, 5 Cess pool, 6 Seepage pit, 7 Pit privy, 8 Sewage lagoon, 9 Feedyard, 10 Livestock pens, 11 Fuel storage, 12 Fertilizer storage, 13 Insecticide storage, 14 Abandoned water well, 15 Oil well/Gas well, 16 Other

Direction from well? W/N

Table with columns: FROM, TO, LITHOLOGIC LOG, FROM, TO, PLUGGING INTERVALS. Entry: 0 TO 72 SILTY CLAY + SHALE

7 CONTRACTOR'S OR LANDOWNER'S CERTIFICATION: This water well was (1) constructed, (2) reconstructed, or (3) plugged under my jurisdiction and was completed on 8/22/94 and this record is true to the best of my knowledge and belief. Kansas Water Well Contractor's License No. 581 This Water Well Record was completed on 8/22/94 under the business name of Rayne, Inc Wichita by signature [Signature]