


WATER WELL RECORD Form WWC-5 KSA 82a-1212

1 LOCATION OF WATER WELL: Fraction NW ¼ SW ¼ NE ¼ Section Number 33 Township Number T 10 S Range Number R 6 **E/V**
 County: Riley

Distance and direction from nearest town or city street address of well if located within city?
Fort Riley Range 16 (approx. 200' N of Vinton School Rd.)

2 WATER WELL OWNER Dir. of Environment & Safety
 RR#, St. Address, Box # Bldg 407, Main Post Board of Agriculture, Division of Water Resources
 City, State, ZIP Code Fort Riley, KS 66442 Application Number:

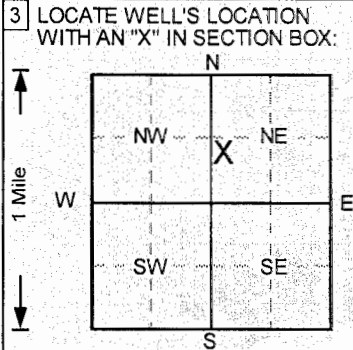

4 DEPTH OF COMPLETED WELL 18.2 ft ELEVATION: 0
 Depth(s) Groundwater Encountered 1 10.6 ft 2 ft 3 ft
 WELL'S STATIC WATER LEVEL 9.89 ft below land surface measured on mo/day/yr 8/18/2005
 Pump test data: Well water was NA ft after hours pumping gpm
 Est. Yield NA gpm Well water was ft after hours pumping gpm
 Bore Hole Diameter 6 in. to 18.2 ft. and in. to ft.
 WELL WATER TO BE USED AS: 5 Public water supply 8 Air conditioning 11 Injection well
 1 Domestic 3 Feedlot 6 Oil field water supply 9 Dewatering 12 Other (Specify below)
 2 Irrigation 4 Industrial 7 Lawn and garden only **10 Monitoring well**
 Was a chemical/bacteriological sample submitted to Department? Yes No
 Water Well Disinfected? Yes No

5 TYPE OF BLANK CASING USED:
 1 Steel 3 RMP (SR) 5 Wrought iron 8 Concrete tile CASING JOINTS: Glued Clamped
2 PVC 4 ABS 6 Asbestos-Cement 9 Other (specify below) Welded
 7 Fiberglass Threaded
 Blank casing diameter 2 in. to 9 ft. Dia in. to ft. Dia in. to ft.
 Casing height above land surface 29.4 in., weight lbs./ft. Wall thickness or gauge No. Sch. 40
 TYPE OF SCREEN OR PERFORATION MATERIAL **7 PVC** 10 Asbestos-cement
 1 Steel 3 Stainless steel 5 Fiberglass 8 RMP (SR) 11 Other (specify)
 2 Brass 4 Galvanized steel 6 Concrete tile 9 ABS 12 None used (open hole)
 SCREEN OR PERFORATION OPENINGS ARE:
 1 Continuous slot **3 Mill slot** 5 Gauzed wrapped 8 Saw cut 11 None (open hole)
 2 Louvered shutter 4 Key punched 6 Wire wrapped 9 Drilled holes
 7 Torch cut 10 Other (specify)
 SCREEN-PERFORATED INTERVALS: From 9 ft. to 18.2 ft. From ft. to ft.
 From ft. to ft. From ft. to ft.
 GRAVEL PACK INTERVALS: From 8 ft. to 18.2 ft. From ft. to ft.
 From ft. to ft. From ft. to ft.

6 GROUT MATERIAL: 1 Neat cement **2 Cement grout** **3 Bentonite** **4 Other Concrete**
 Grout Intervals: From 0 ft. to 2 ft. From 2 ft. to 5 ft. From 5 ft. to 8 ft.
 What is the nearest source of possible contamination:
 1 Septic tank 4 Lateral lines 7 Pit privy 10 Livestock pens 14 Abandoned water well
 2 Sewer lines 5 Cess pool 8 Sewage lagoon 11 Fuel storage 15 Oil well/Gas well
 3 Watertight sewer lines 6 Seepage pit 9 Feedyard 12 Fertilizer storage 16 Other (specify below)
 13 Insecticide storage
 Direction from well? How many feet? 0

FROM	TO	LITHOLOGIC LOG	FROM	TO	PLUGGING INTERVALS
0	0.7	Clay, damp, med. consistency, med. plas.,			
0.7	2	Clay, silty, dry, nonplastic, hard w/roots. Bro			
2	3	Silt, dry, nonplastic, hard w/roots, mottling. B			
3	6	Clay, silty, camp, tr. to med. plasticity, Brown			
6	12.5	Clay, damp to moist, med. to high plasticity, B			
12.5	14	Clay, moist to wet, high plasticity, soft,			
14	17.5	Clay, wet, high plasticity, soft consistency, Lt.			
17.5	18.2	Shale, dry, fissile, Lt. Olive Gray			

MW05-15, Abovegrade
 Project Name: BM - Ft. Riley
 GeoCore # 667, #

7 CONTRACTOR'S OR LANDOWNER'S CERTIFICATION: This water well was **1** constructed, **2** reconstructed, or **3** plugged under my jurisdiction and was completed on (mo/day/year) 8/16/2005 and this record is true to the best of my knowledge and belief.
 Kansas Water Well Contractor's License No. 527 This Water Well Record was completed on (mo/day/yr) 8/24/05
 under the business name of GeoCore, Inc. by (signature) Dan Hill