

WATER WELL PLUGGING RECORD Form WWC-5P

KSA 82a-1212

ID NO.

03-97-1302-4

1 LOCATION OF WATER WELL:	Fraction	Section Number	Township Number	Range Number
County: <u>Riley</u>	<u>1/4 NE 1/4 SW 1/4 NW 1/4</u>	<u>33</u>	T <u>10</u> S	<u>6</u> <input checked="" type="checkbox"/> E <input type="checkbox"/> W

Street/Rural Address of Well Location; if unknown, distance & direction from nearest town or intersection: If at owner's address, check here ☐

Global Positioning Systems (GPS) information:

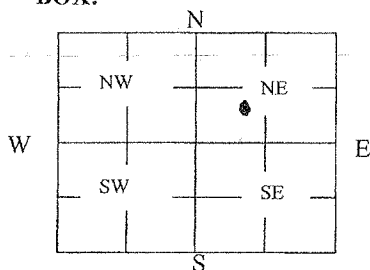
Latitude: 1663170.91 (in decimal degrees)Longitude: 296604.87 (in decimal degrees)Elevation: 1157.12Datum: ☐ WGS84, ☐ NAD83, ☐ NAD27

Collection Method:

☐ GPS unit (Make/Model: _____)☐ Digital Map/Photo, ☐ Topographic Map, ☒ Land SurveyEst. Accuracy: ☐ < 3 m, ☐ 3-5 m, ☐ 5-15 m, ☐ > 15 m

2 WATER WELL OWNER: Directorate of Public Works
Co. Dr. Richard SWIEIOS
 RR#, St. Address, Box #: 407 main Post
 City, State ZIP Code: St Riley KS 66442

3 MARK WELL'S LOCATION WITH AN "X" IN SECTION BOX:

4 DEPTH OF WELL 14.22 ft.WELL'S STATIC WATER LEVEL 14.09 ft

WELL WAS USED AS:

☐ Domestic
☐ Irrigation
☐ Feedlot
☐ Industrial

☐ Public Water Supply
☐ Oil Field Water Supply
☐ Domestic (Lawn & Garden)
☐ Air Conditioning

☒ Dewatering
☐ Monitoring
☐ Injection Well
☐ Other _____
Was a chemical/bacteriological sample submitted to Department? Yes ☐ No ☒

5 TYPE OF BLANK CASING USED:

☐ Steel
☒ PVC☐ RMP (SR)
☐ ABS☐ Wrought
☐ Asbestos-Cement☐ Fiberglass
☐ Concrete Tile☐ Other (Specify below) _____

Blank casing diameter 1 in. Was casing pulled? Yes ☐ No ☒ If yes, how much _____
 Casing height above or below land surface 36" in.

6 GROUT PLUG MATERIAL: ☒ Neat cement ☐ Cement grout ☐ Bentonite ☐ Other _____Grout Plug Intervals: From 14.22 ft. to 0 ft., From _____ ft. to _____ ft., From _____ to _____ ft.

What is the nearest source of possible contamination:

☐ Septic tank
☐ Sewer lines
☐ Watertight sewer lines
☐ Lateral lines
☐ Cess pool

☐ Seepage pit
☐ Pit privy
☐ Sewage lagoon
☐ Feedyard
☐ Livestock pens

☐ Fuel Storage
☐ Fertilizer storage
☐ Insecticide storage
☐ Abandoned water well
☐ Oil well/Gas well
☒ Other (specify below)Range 16 Ft Riley KSDirection from well? n/aHow many feet? n/a

FROM	TO	PLUGGING MATERIALS	FROM	TO	PLUGGING MATERIALS
<u>14.22</u>	<u>0</u>	<u>NEAT Cement</u>			

7 CONTRACTOR'S OR LANDOWNER'S CERTIFICATION: This water well was plugged under my jurisdiction and was completed on (mo/day/year) 2-25-2012 and this record is true to the best of my knowledge and belief. Kansas Water Well Contractor's License No. 597. This Water Well Record was completed on (mo/day/year) 3-15-2012 under the business name of Burnt Honey Co by (signature) Chad Water

INSTRUCTIONS: Use typewriter or ballpoint pen. Please press firmly and print clearly. Please fill in blanks, underline or circle the correct answers. Send top three copies to Kansas Department of Health and Environment, Bureau of Water, Geology Section, 1000 SW Jackson St., Ste. 420, Topeka, Kansas 66612-1367, Telephone: 785/296-5524. Send one to Water Well Owner and retain one for your records. Visit us at <http://www.kdheks.gov/waterwell/index.html>.