

County: Riley Fraction: NW SW NE Sec. 33 T. 10 S R. 6 E

CORRECTION(S) to WATER WELL COMPLETION RECORD Form WWC-5 (to rectify lacking or incorrect information)

Owner: Directorate of Public Works OB 18-24 D

If location corrected, was listed as:

Section-Township-Range: _____

Fraction (1/4 calls): _____

Location changed to:

Other changes: Initial statements: County Change

Changed to: Geary

Comments: Riley

Verification method: County Checker and WCC5 Mapper

Initials: SW Date: 05-14-2019

Submitted by: Kansas Geological Survey, Data Resources Library, 1930 Constant Ave., Lawrence, KS 66047-3724
 Kansas Dept. of Health & Environment, Bureau of Water, 1000 SW Jackson, Suite 420, Topeka, KS 66612-1367

WATER WELL RECORD Form WWC-5


Original Record Correction Change in Well Use

Division of Water Resources App. No.

Well ID OB-18-24D

1 LOCATION OF WATER WELL:
 County: Geary Fraction NW 1/4 SW 1/4 NE 1/4 1/4 Section Number 33 Township Number T 10 S Range Number R 6 E W

2 WELL OWNER: Last Name: Jones First: Dave
 Business: Directorate of Public Works Street or Rural Address where well is located (if unknown, distance and direction from nearest town or intersection): If at owner's address, check here:
 Address: 407 Main Post 3000' North of Vinton School Road & Range 16 Access Rd.
 City: Ft. Riley State: KS ZIP: 64114

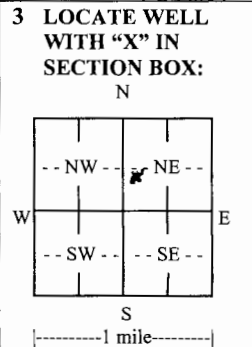

4 DEPTH OF COMPLETED WELL: 54 ft.
 Depth(s) Groundwater Encountered: 1) ft.
 2) ft. 3) ft., or 4) Dry Well
 WELL'S STATIC WATER LEVEL: 31.51 ft.
 below land surface, measured on (mo-day-yr)
 above land surface, measured on (mo-day-yr)
 Pump test data: Well water was NA ft.
 after hours pumping gpm
 Well water was ft.
 after hours pumping gpm
 Estimated Yield: gpm
 Bore Hole Diameter: 6 in. to 54 ft. and
 in. to ft.

5 Latitude: 39.141548 (decimal degrees)
Longitude: -96.764529 (decimal degrees)
 Horizontal Datum: WGS 84 NAD 83 NAD 27
 Source for Latitude/Longitude:
 GPS (unit make/model: (WAAS enabled? Yes No)
 Land Survey Topographic Map
 Online Mapper: Google Earth

6 Elevation: ft. Ground Level TOC
 Source: Land Survey GPS Topographic Map
 Other

7 WELL WATER TO BE USED AS:

1. Domestic: <input type="checkbox"/> Household <input type="checkbox"/> Lawn & Garden <input type="checkbox"/> Livestock	5. <input type="checkbox"/> Public Water Supply: well ID	10. <input type="checkbox"/> Oil Field Water Supply: lease
2. <input type="checkbox"/> Irrigation	6. <input type="checkbox"/> Dewatering: how many wells?	11. Test Hole: well ID
3. <input type="checkbox"/> Feedlot	7. <input type="checkbox"/> Aquifer Recharge: well ID	<input type="checkbox"/> Cased <input type="checkbox"/> Uncased <input type="checkbox"/> Geotechnical
4. <input type="checkbox"/> Industrial	8. <input checked="" type="checkbox"/> Monitoring: well ID <u>OB-18-24D</u>	12. Geothermal: how many bores?
	9. Environmental Remediation: well ID	a) Closed Loop <input type="checkbox"/> Horizontal <input type="checkbox"/> Vertical
	<input type="checkbox"/> Air Sparge <input type="checkbox"/> Soil Vapor Extraction	b) Open Loop <input type="checkbox"/> Surface Discharge <input type="checkbox"/> Inj. of Water
	<input type="checkbox"/> Recovery <input type="checkbox"/> Injection	13. <input type="checkbox"/> Other (specify):

Was a chemical/bacteriological sample submitted to KDHE? Yes No If yes, date sample was submitted:

8 TYPE OF CASING USED: Steel PVC Other CASING JOINTS: Glued Clamped Welded Threaded
 Casing diameter 2 in. to 45 ft., Diameter in. to ft., Diameter in. to ft.
 Casing height above land surface 30 in. Weight lbs./ft. Wall thickness or gauge No. SCH 40

TYPE OF SCREEN OR PERFORATION MATERIAL:
 Steel Stainless Steel Fiberglass PVC Other (Specify)
 Brass Galvanized Steel Concrete tile None used (open hole)

SCREEN OR PERFORATION OPENINGS ARE:
 Continuous Slot Mill Slot Gauze Wrapped Torch Cut Drilled Holes Other (Specify)
 Louvered Shutter Key Punched Wire Wrapped Saw Cut None (Open Hole)

SCREEN-PERFORATED INTERVALS: From 45 ft. to 54 ft., From ft. to ft., From ft. to ft.
 GRAVEL PACK INTERVALS: From 42 ft. to 54 ft., From ft. to ft., From ft. to ft.

9 GROUT MATERIAL: Neat cement Cement grout Bentonite Other Type / Ill Cement/Bentonite

Grout Intervals: From 3 ft. to 42 ft., From 0 ft. to 3 ft., From ft. to ft.

Nearest source of possible contamination:
 Septic Tank Lateral Lines Pit Privy Livestock Pens Insecticide Storage
 Sewer Lines Cess Pool Sewage Lagoon Fuel Storage Abandoned Water Well
 Watertight Sewer Lines Seepage Pit Feedyard Fertilizer Storage Oil Well/Gas Well
 Other (Specify) Open Burning / Open Detonation Pits

Direction from well? Distance from well? ft.

10 FROM	TO	LITHOLOGIC LOG	FROM	TO	LITHO. LOG (cont.) or PLUGGING INTERVALS
0	25.2	Drilled prior to install. Steel Surface Casing	53	54	limestone
25.2	31	Shale / Shaly Limestone	54	54	Shale
31	32	Limestone			
32	38	Shale			
38	40	Limestone			
40	41	Calcite Seam			*** Entire Site is OB/OD Range @ Ft. Riley, KS
41	51	Limestone	Notes: REDI # 172030		
51	52	Shale			
52	53	Shaly Limestone			

11 CONTRACTOR'S OR LANDOWNER'S CERTIFICATION: This water well was constructed, reconstructed, or plugged under my jurisdiction and was completed on (mo-day-year) 12/21/18 and this record is true to the best of my knowledge and belief. Kansas Water Well Contractor's License No. 903 This Water Well Record was completed on (mo-day-year) 01/17/19 under the business name of Roberts Env. Drilling, Inc. - Travis Roberts Signature Travis Roberts