

County: Riley Fraction: NW SW NE Sec. 33 T. 10 S R. 6 E

CORRECTION(S) to WATER WELL COMPLETION RECORD Form WWC-5 (to rectify lacking or incorrect information)

Owner: Directorate of Public Works OB 18-27 D

If location corrected, was listed as: Location changed to:

Section-Township-Range: _____ | _____

Fraction (1/4 calls): _____ | _____

Other changes: Initial statements: County Change

Changed to: Geary

Comments: Riley

Verification method: County Checker and WCC5 Mapper

Initials: SW Date: 05-14-2019

Submitted by: Kansas Geological Survey, Data Resources Library, 1930 Constant Ave., Lawrence, KS 66047-3724
 Kansas Dept. of Health & Environment, Bureau of Water, 1000 SW Jackson, Suite 420, Topeka, KS 66612-1367

WATER WELL RECORD Form WWC-5


Division of Water Resources App. No.

Well ID OB-18-27D

Original Record Correction Change in Well Use

1 LOCATION OF WATER WELL: County: <u>Geary</u>	Fraction NW ¼ SW ¼ NE ¼ ¼	Section Number 33	Township Number T 10 S	Range Number R 6 <input checked="" type="checkbox"/> E <input type="checkbox"/> W
--	------------------------------	-----------------------------	----------------------------------	---

2 WELL OWNER: Last Name: <u>Jones</u> First: <u>Dave</u> Business: <u>Directorate of Public Works</u> Address: <u>407 Main Post</u> Address: City: <u>Ft. Riley</u> State: <u>KS</u> ZIP: <u>64114</u>	Street or Rural Address where well is located (if unknown, distance and direction from nearest town or intersection): If at owner's address, check here: <input type="checkbox"/> <u>3000' North of Vinton School Road & Range 16 Access Rd.</u>
---	---

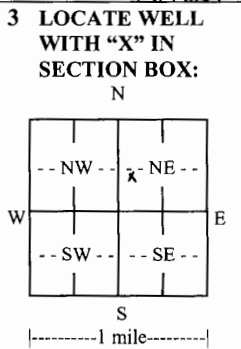

4 DEPTH OF COMPLETED WELL: 53 ft.

Depth(s) Groundwater Encountered: 1) ft.
 2) ft. 3) ft., or 4) Dry Well

WELL'S STATIC WATER LEVEL: 25.88 ft.
 below land surface, measured on (mo-day-yr).....
 above land surface, measured on (mo-day-yr).....

Pump test data: Well water was NA ft.
 after..... hours pumping gpm
 Well water was ft.
 after..... hours pumping gpm

Estimated Yield:gpm
 Bore Hole Diameter: 6 in. to 53 ft. and
 in. to ft.

5 Latitude: 39.140545 (decimal degrees)
Longitude: -96.764735 (decimal degrees)
 Horizontal Datum: WGS 84 NAD 83 NAD 27
Source for Latitude/Longitude:
 GPS (unit make/model:)
 (WAAS enabled? Yes No)
 Land Survey Topographic Map
 Online Mapper: Google Earth

6 Elevation:ft. Ground Level TOC
Source: Land Survey GPS Topographic Map
 Other

7 WELL WATER TO BE USED AS:

1. Domestic: <input type="checkbox"/> Household <input type="checkbox"/> Lawn & Garden <input type="checkbox"/> Livestock 2. <input type="checkbox"/> Irrigation 3. <input type="checkbox"/> Feedlot 4. <input type="checkbox"/> Industrial	5. <input type="checkbox"/> Public Water Supply: well ID 6. <input type="checkbox"/> Dewatering: how many wells? 7. <input type="checkbox"/> Aquifer Recharge: well ID 8. <input checked="" type="checkbox"/> Monitoring: well ID <u>OB-18-27D</u> 9. Environmental Remediation: well ID <input type="checkbox"/> Air Sparge <input type="checkbox"/> Soil Vapor Extraction <input type="checkbox"/> Recovery <input type="checkbox"/> Injection	10. <input type="checkbox"/> Oil Field Water Supply: lease 11. Test Hole: well ID <input type="checkbox"/> Cased <input type="checkbox"/> Uncased <input type="checkbox"/> Geotechnical 12. Geothermal: how many bores? a) Closed Loop <input type="checkbox"/> Horizontal <input type="checkbox"/> Vertical b) Open Loop <input type="checkbox"/> Surface Discharge <input type="checkbox"/> Inj. of Water 13. <input type="checkbox"/> Other (specify):
---	--	---

Was a chemical/bacteriological sample submitted to KDHE? Yes No If yes, date sample was submitted:

Water well disinfected? Yes No

8 TYPE OF CASING USED: Steel PVC Other CASING JOINTS: Glued Clamped Welded Threaded

Casing diameter 2 in. to 44 ft., Diameter in. to ft., Diameter in. to ft.
 Casing height above land surface 30 in. Weight lbs./ft. Wall thickness or gauge No. SCH 40

TYPE OF SCREEN OR PERFORATION MATERIAL:
 Steel Stainless Steel Fiberglass PVC Other (Specify)
 Brass Galvanized Steel Concrete tile None used (open hole)

SCREEN OR PERFORATION OPENINGS ARE:
 Continuous Slot Mill Slot Gauze Wrapped Torch Cut Drilled Holes Other (Specify)
 Louvered Shutter Key Punched Wire Wrapped Saw Cut None (Open Hole)

SCREEN-PERFORATED INTERVALS: From 44 ft. to 53 ft., From ft. to ft., From ft. to ft.
GRAVEL PACK INTERVALS: From 41 ft. to 53 ft., From ft. to ft., From ft. to ft.

9 GROUT MATERIAL: Neat cement Cement grout Bentonite Other Type I/II Cement/Bentonite

Grout Intervals: From 3 ft. to 41 ft., From 0 ft. to 3 ft., From ft. to ft.

Nearest source of possible contamination:
 Septic Tank Lateral Lines Pit Privy Livestock Pens Insecticide Storage
 Sewer Lines Cess Pool Sewage Lagoon Fuel Storage Abandoned Water Well
 Watertight Sewer Lines Seepage Pit Feedyard Fertilizer Storage Oil Well/Gas Well
 Other (Specify) Open Burning./Open Detonation.Pits.....

Direction from well? *** Distance from well? *** ft.

10 FROM	TO	LITHOLOGIC LOG	FROM	TO	LITHO. LOG (cont.) or PLUGGING INTERVALS
0	19	Drilled prior to install-Steel Surface Casing			
19	22	Limestone			
22	25	Shale			
25	26	Limestone			
26	32	Shale			
32	33	Limestone			
33	35	Shale			
35	48	Limestone			
48	53	Shale			

Notes: REDI # 172030

11 CONTRACTOR'S OR LANDOWNER'S CERTIFICATION: This water well was constructed, reconstructed, or plugged under my jurisdiction and was completed on (mo-day-year) 12/21/18 and this record is true to the best of my knowledge and belief. Kansas Water Well Contractor's License No. 903 This Water Well Record was completed on (mo-day-year) 01/17/19 under the business name of Roberts Env. Drilling, Inc. Travis Roberts Signature Travis Roberts