


GP-2

1 LOCATION OF WATER WELL: County: Riley Fraction SW 1/4 SE 1/4 NE 1/4 Section Number 36 Township Number T 10 S Range Number R 7 E/W

Distance and direction from nearest town or city street address of well if located within city? located S of Manhattan approx. 2 1/2 miles/Riley County Landfill

2 WATER WELL OWNER: Riley County Attn: Dan Harden RR#, St. Address, Box # 110 Courthouse Plaza, Manhattan, Ks 66502 Board of Agriculture, Division of Water Resources Application Number:

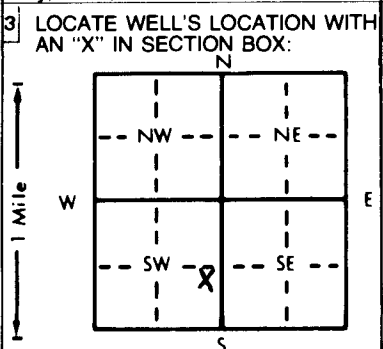

3 LOCATE WELL'S LOCATION WITH AN 'X' IN SECTION BOX: 4 DEPTH OF COMPLETED WELL: 21.75 ft. ELEVATION: 11.0 ft. WELL'S STATIC WATER LEVEL: 13.44 ft. below land surface measured on 8/25/95

5 TYPE OF BLANK CASING USED: 1 Steel 2 PVC 3 RMP (SR) 4 ABS 5 Wrought iron 6 Asbestos-Cement 7 Fiberglass 8 Concrete tile 9 Other (specify below) 10 Asbestos-cement 11 Injection well 12 None used (open hole)

Blank casing diameter: 18 in. Dia: SCH 40 PVC Casing height above land surface: 18 in. weight: lbs./ft. Wall thickness or gauge No. TYPE OF SCREEN OR PERFORATION MATERIAL: 1 Steel 2 Brass 3 Stainless steel 4 Galvanized steel 5 Fiberglass 6 Concrete tile 7 PVC 8 RMP (SR) 9 ABS 10 Asbestos-cement 11 Other (specify) 12 None used (open hole)

SCREEN OR PERFORATION OPENINGS ARE: 1 Continuous slot 2 Louvered shutter 3 Mill slot 4 Key punched 5 Gauzed wrapped 6 Wire wrapped 7 Torch cut 8 Saw cut 9 Drilled holes 10 Other (specify) 11 None (open hole) SCREEN-PERFORATED INTERVALS: From 6 ft. to 21.75 ft. GRAVEL PACK INTERVALS: SAND Pack From 5 ft. to 25 ft.

6 GROUT MATERIAL: 1 Neat cement 2 0 3 Cement grout 4 Bentonite 4 Other Grout Intervals: From 3 ft. to 3 ft. to 4 ft. What is the nearest source of possible contamination: 1 Septic tank 2 Sewer lines 3 Watertight sewer lines 4 Lateral lines 5 Cess pool 6 Seepage pit 7 Pit privy 8 Sewage lagoon 9 Feedyard 10 Livestock pens 11 Fuel storage 12 Fertilizer storage 13 Insecticide storage 14 Abandoned water well 15 Oil well/Gas well 16 Other (specify below) Landfill

Table with columns: FROM, TO, LITHOLOGIC LOG, FROM, TO, PLUGGING INTERVALS. Rows include: GL 1.50 Fill, surface silts/clays; 1.50 25.00 Sand (SP), w/silt, tan, fine; 25.00 TD End of Borehole

7 CONTRACTOR'S OR LANDOWNER'S CERTIFICATION: This water well was (1) constructed, (2) reconstructed, or (3) plugged under my jurisdiction and was completed on (mo/day/year) 8/21/95 and this record is true to the best of my knowledge and belief. Kansas Water Well Contractor's License No. 585 This Water Well Record was completed on (mo/day/yr) 9/6/95 under the business name of Associated Environmental, Inc. by (signature) Dee Johnson for Darin Duncan

OFFICE USE ONLY T R E/W SEC. 1/4 1/4 1/4