


1 LOCATION OF WATER WELL: County: Riley Fraction: SE 1/4 SE 1/4 SE 1/4 Section Number: 11 Township Number: T 10 S Range Number: R 7 EW

Distance and direction from nearest town or city street address of well if located within city? 2829 W Anderson Ave Manhattan

2 WATER WELL OWNER: RR#, St. Address, Box #: Rxs Tire 2829 Anderson Ave W. 100 Manhattan, MO 64614 Board of Agriculture, Division of Water Resources Application Number:

3 LOCATE WELL'S LOCATION WITH AN "X" IN SECTION BOX:

4 DEPTH OF COMPLETED WELL: 26.5 ft. ELEVATION:

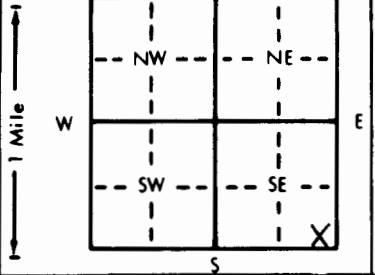

Depth(s) Groundwater Encountered 1. ft. 2. ft. 3. ft. WELL'S STATIC WATER LEVEL ft. below land surface measured on mo/day/yr Pump test data: Well water was ft. after hours pumping gpm Est. Yield gpm: Well water was ft. after hours pumping gpm Bore Hole Diameter: 7.4 in. to 26.5 ft., and in. to ft. WELL WATER TO BE USED AS: 5 Public water supply 8 Air conditioning 11 Injection well 1 Domestic 3 Feedlot 6 Oil field water supply 9 Dewatering 12 Other (Specify below) 2 Irrigation 4 Industrial 7 Lawn and garden only 10 Monitoring well Was a chemical/bacteriological sample submitted to Department? Yes No ; If yes, mo/day/yr sample was submitted Water Well Disinfected? Yes No

5 TYPE OF BLANK CASING USED: 1 Steel 3 RMP (SR) 5 Wrought iron 8 Concrete tile CASING JOINTS: Glued Clamped 2 Brass 4 Galvanized steel 6 Asbestos-Cement 9 Other (specify below) Welded Threaded 3 PVC 4 ABS 7 Fiberglass

Blank casing diameter 2 in. to 11.5 ft., Dia in. to ft., Dia in. to ft. Casing height above land surface 0 in., weight Sch 40 lbs./ft. Wall thickness or gauge No.

TYPE OF SCREEN OR PERFORATION MATERIAL: 1 Steel 3 Stainless steel 5 Fiberglass 8 RMP (SR) 10 Asbestos-cement 2 Brass 4 Galvanized steel 6 Concrete tile 9 ABS 11 Other (specify) 12 None used (open hole)

SCREEN OR PERFORATION OPENINGS ARE: 1 Continuous slot 2 Louvered shutter 3 Mill slot 0.10 4 Key punched 5 Gauzed wrapped 6 Wire wrapped 7 Torch cut 8 Saw cut 10 Other (specify) 11 None (open hole) 9 Drilled holes

SCREEN-PERFORATED INTERVALS: From 26.5 ft. to 11.5 ft., From ft. to ft. GRAVEL PACK INTERVALS: From 26.5 ft. to 9.5 ft., From ft. to ft.

6 GROUT MATERIAL: 1 Neat cement 2 Cement grout 3 Bentonite 4 Other Grout Intervals: From 6.5 ft. to 9.5 ft., From 9.5 ft. to 6.5 ft., From ft. to ft.

What is the nearest source of possible contamination: 1 Septic tank 4 Lateral lines 7 Pit privy 10 Livestock pens 14 Abandoned water well 2 Sewer lines 5 Cess pool 8 Sewage lagoon 11 Fuel storage 15 Oil well/Gas well 3 Watertight sewer lines 6 Seepage pit 9 Feedyard 12 Fertilizer storage 16 Other (specify below) 13 Insecticide storage

Direction from well? S.W. How many feet? 21'

Table with columns: FROM, TO, LITHOLOGIC LOG, FROM, TO, PLUGGING INTERVALS. Rows include: 0-6' Concrete, 6'-20' Fill Material, 20'-26' Tan Brn Silty Clay, 26'-26.5' Silty Sandy Brn Clay, 26'-26.5' Bedrock 1.M.S. STONE

7 CONTRACTOR'S OR LANDOWNER'S CERTIFICATION: This water well was (1) constructed, (2) reconstructed, or (3) plugged under my jurisdiction and was completed on (mo/day/year) 11-3-97 and this record is true to the best of my knowledge and belief. Kansas Water Well Contractor's License No. 575 This Water Well Record was completed on (mo/day/yr) 12-1-97 under the business name of Kurtz Environmental Service by (signature)