


1 LOCATION OF WATER WELL: Fraction E 1/4 SW 1/4 NE 1/4 Section Number 15 Township Number T 10 S Range Number R 7 EW

County: Riley  
 Distance and direction from nearest town or city street address of well if located within city? IN MANHATTAN TAKE ANDERSON AVE. WEST TO FRANK ANNEBERG PARK PROCEED SOUTH IN PARK ALONG EAST SIDE TO THE SOUTHEAST OF THE LAKE WELL IS APPROXIMATELY 300' SOUTH OF THE LAKE ON THE WEST SIDE

2 WATER WELL OWNER: CITY OF MANHATTAN PARKS & RECREATION DEPT.  
 RR#, St. Address, Box #: CITY OFFICE P.O. BOX 748  
 City, State, ZIP Code: Manhattan, KS 66502  
 Board of Agriculture, Division of Water Resources  
 Application Number:

3 LOCATE WELL'S LOCATION WITH AN "X" IN SECTION BOX:  
 4 DEPTH OF COMPLETED WELL: 40 ft. ELEVATION:  
 Depth(s) Groundwater Encountered 1. 29 ft. 2. ft. 3. ft.

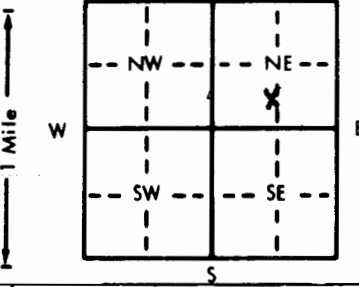

WELL'S STATIC WATER LEVEL: 15 ft. below land surface measured on mo/day/yr  
 Pump test data: Well water was ft. after hours pumping gpm  
 Est. Yield: 100 gpm: Well water was ft. after hours pumping gpm  
 Bore Hole Diameter: 8 in. to 40 ft., and in. to ft.  
 WELL WATER TO BE USED AS:  
 5 Public water supply 8 Air conditioning 11 Injection well  
 1 Domestic 3 Feedlot 6 Oil field water supply 9 Dewatering 12 Other (Specify below) Pond Well  
 2 Irrigation 4 Industrial 7 Lawn and garden only 10 Monitoring well  
 Was a chemical/bacteriological sample submitted to Department? Yes No X; If yes, mo/day/yr sample was submitted  
 Water Well Disinfected? Yes No

5 TYPE OF BLANK CASING USED:  
 1 Steel 3 RMP (SR) 5 Wrought iron 8 Concrete tile CASING JOINTS: Glued & Clamped  
2 PVC 4 ABS 7 Fiberglass  
 Blank casing diameter: 5 in. to 20 ft., Dia. in. to ft., Dia. in. to ft.  
 Casing height above land surface: 24" in., weight 5.4 lbs./ft. Wall thickness or gauge No.

TYPE OF SCREEN OR PERFORATION MATERIAL:  
 1 Steel 3 Stainless steel 5 Fiberglass 8 RMP (SR) 11 Other (specify)  
 2 Brass 4 Galvanized steel 6 Concrete tile 9 ABS 12 None used (open hole)  
 SCREEN OR PERFORATION OPENINGS ARE:  
 1 Continuous slot 3 Mill slot 31/1000 6 Wire wrapped 8 Saw cut 11 None (open hole)  
 2 Louvered shutter 4 Key punched 7 Torch cut 10 Other (specify)

SCREEN-PERFORATED INTERVALS: From 20 ft. to 40 ft., From ft. to ft.  
 GRAVEL PACK INTERVALS: From 20 ft. to 40 ft., From ft. to ft.

6 GROUT MATERIAL: 1 Neat cement 2 Cement grout 3 Bentonite 4 Other  
 Grout Intervals: From 0 ft. to 20 ft., From ft. to ft., From ft. to ft.

What is the nearest source of possible contamination: None Close  
 1 Septic tank 4 Lateral lines 7 Pit privy 10 Livestock pens 14 Abandoned water well  
 2 Sewer lines 5 Cess pool 8 Sewage lagoon 11 Fuel storage 15 Oil well/Gas well  
 3 Watertight sewer lines 6 Seepage pit 9 Feedyard 12 Fertilizer storage 16 Other (specify below)  
 13 Insecticide storage  
 Direction from well? How many feet?

FROM	TO	LITHOLOGIC LOG	FROM	TO	PLUGGING INTERVALS
0	4	TOP SOIL			
4	29	BROWN CLAY			
29	37	GRAVEL			
37	40	SHALE			

7 CONTRACTOR'S OR LANDOWNER'S CERTIFICATION: This water well was (1) constructed, (2) reconstructed, or (3) plugged under my jurisdiction and was completed on (mo/day/year) 7/3/89 and this record is true to the best of my knowledge and belief. Kansas Water Well Contractor's License No. 451 This Water Well Record was completed on (mo/day/yr) 8/29/89 under the business name of HALDEMAN well Drilling by (signature) Craig

OFFICE USE ONLY  
T  
R  
EW  
SEC.  
1/4  
1/4  
1/4