


1 LOCATION OF WATER WELL: County: RILEY	Fraction SE 1/4 SE 1/4 SE 1/4	Section Number 2	Township Number T 10 S	Range Number R 7 E/W
---	----------------------------------	----------------------------	---------------------------	-------------------------

Distance and direction from nearest town or city street address of well if located within city?
Well site @ 2210 Terryway Drive in Manhattan

2 WATER WELL OWNER: Owen Gaul
RR#, St. Address, Box #: 2210 Terryway Drive RAY'S JOB Board of Agriculture, Division of Water Resources
City, State, ZIP Code: Manhattan, KS 66502 Application Number:

3 LOCATE WELL'S LOCATION WITH AN "X" IN SECTION BOX:

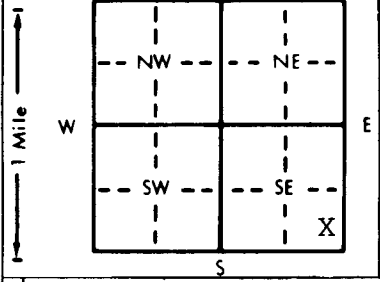

4 DEPTH OF COMPLETED WELL... 79' ft. ELEVATION:
Depth(s) Groundwater Encountered 1. 57' ft. 2. ft. 3. ft.
WELL'S STATIC WATER LEVEL .12/11/98ft. below land surface measured on mo/day/yr .12/11/98
Pump test data: Well water was ft. after hours pumping gpm
Est. Yield .10 gpm: Well water ft. after hours pumping gpm
Bore Hole Diameter .8. 3/4 .in. to ft., and .in. to ft.
WELL WATER TO BE USED AS: 5 Public water supply 8 Air conditioning 11 Injection well
1 Domestic 3 Feedlot 6 Oil field water supply 9 Dewatering 12 Other (Specify below)
2 Irrigation 4 Industrial 7 Lawn and garden only 10 Monitoring well
Was a chemical/bacteriological sample submitted to Department? Yes.....No.; If yes, mo/day/yr sample was submitted
Water Well Disinfected? Yes No

5 TYPE OF BLANK CASING USED:
1 Steel 3 RMP (SR) 5 Wrought iron 8 Concrete tile CASING JOINTS: Glued Clamped
2 PVC 4 ABS 6 Asbestos-Cement 9 Other (specify below) Welded
7 Fiberglass Threaded
Blank casing diameter 0-49 in. to ft., Dia in. to ft., Dia in. to ft.
Casing height above land surface .24 in., weight 2.82 lbs./ft. Wall thickness or gauge No. 258
TYPE OF SCREEN OR PERFORATION MATERIAL:
1 Steel 3 Stainless steel 5 Fiberglass 7 PVC 10 Asbestos-cement
2 Brass 4 Galvanized steel 6 Concrete tile 8 RMP (SR) 11 Other (specify)
6 Concrete tile 9 ABS 12 None used (open hole)
SCREEN OR PERFORATION OPENINGS ARE:
1 Continuous slot 3 Mill slot 5 Gauzed wrapped 8 Saw cut 11 None (open hole)
2 Louvered shutter 4 Key punched 6 Wire wrapped 9 Drilled holes
7 Torch cut 10 Other (specify)
SCREEN-PERFORATED INTERVALS: From 49 ft. to 79 ft., From ft. to ft.
GRAVEL PACK INTERVALS: From 24 ft. to 79 ft., From ft. to ft.

6 GROUT MATERIAL: 1 Neat cement 2 Cement grout 3 Bentonite 4 Other
Grout Intervals: From 4 ft. to 24 ft., From ft. to ft., From ft. to ft.
What is the nearest source of possible contamination:
1 Septic tank 4 Lateral lines 7 Pit privy 10 Livestock pens 14 Abandoned water well
2 Sewer lines 5 Cess pool 8 Sewage lagoon 11 Fuel storage 15 Oil well/Gas well
3 Watertight sewer lines 6 Seepage pit 9 Feedyard 12 Fertilizer storage 16 Other (specify below)
13 Insecticide storage
Direction from well? EAST How many feet? 80'

FROM	TO	LITHOLOGIC LOG	FROM	TO	PLUGGING INTERVALS
0	1	Top Soil	78	79	Shale-Grey
1	32	Clay-Brown-Silty			
32	36	Clay-Brown			
36	37	Chert Gravel, Clay-Brown			
37	42	Clay-Brown			
42	43	Chert Gravel, Clay-Brown			
43	53	Limestone-Tan			
53	54	Shale-Grey			
54	56	Limestone-Brown-Loose			
56	60	Limestone-Tan			
60	68	Shale-Grey			
68	70	Limestone-Tan-loose			
70	74	Limestone-Grey			
74	75	Shale-Grey			
75	78	Limestone-Grey			

7 CONTRACTOR'S OR LANDOWNER'S CERTIFICATION: This water well was (1) constructed, (2) reconstructed, or (3) plugged under my jurisdiction and was completed on (mo/day/year) 12/11/98 and this record is true to the best of my knowledge and belief. Kansas Water Well Contractor's License No. 182 This Water Well Record was completed on (mo/day/yr) 1-5-99 under the business name of STRADER DRILLING CO., INC. by (signature) D. A. Skren