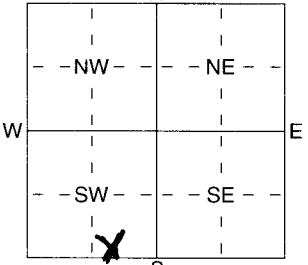


1 LOCATION OF WATER WELL: Fraction SW 1/4 S8E 1/4 SW 1/4 Section Number 3 Township Number T 10 S Range Number R 7 E
 County: RILEY

Distance and direction from nearest town or city street address of well if located within city?
1/2 MILE WEST OF MANHATTAN AT COLBERT HILLS

2 WATER WELL OWNER: THEATER CONSR.
 RR#, St. Address, Box # : 1208 WYNDHAM HWY 26 HTS
 City, State, ZIP Code : MANHATTAN, KS. 66503
 Board of Agriculture, Division of Water Resources
 Application Number: _____

3 LOCATE WELL'S LOCATION WITH AN "X" IN SECTION BOX:

 4 DEPTH OF COMPLETED WELL 240 ft. ELEVATION: _____
 Depth(s) Groundwater Encountered 1 191 ft. 2 _____ ft. 3 _____ ft.
 WELL'S STATIC WATER LEVEL _____ ft. below land surface measured on mo/day/yr _____
 Pump test data: Well water was _____ ft. after _____ hours pumping _____ gpm
 Est. Yield 20-30 gpm: Well water was _____ ft. after _____ hours pumping _____ gpm
 WELL WATER TO BE USED AS:
 1 Domestic 3 Feedlot 6 Oil field water supply 9 Dewatering Other (Specify below)
 2 Irrigation 4 Industrial 7 Domestic (lawn & garden) 10 Monitoring well CLOSED LOOP CROWDISBORO
 5 Public water supply 8 Air conditioning 11 Injection well
 Was a chemical/bacteriological sample submitted to Department? Yes _____ No ; If yes, mo/day/yr sample was submitted _____
 Water Well Disinfected? Yes _____ No

5 TYPE OF BLANK CASING USED:
 1 Steel 3 RMP (SR) 5 Wrought iron 8 Concrete tile CASING JOINTS: Glued _____ Clamped _____
 2 PVC 4 ABS 6 Asbestos-Cement 9 Other (specify below) Welded
 7 Fiberglass NONE Threaded _____
 Blank casing diameter 3 1/4 in. to 240 ft., Dia _____ in. to _____ ft., Dia _____ in. to _____ ft.
 Casing height 48 ft. above land surface _____ in., weight _____ lbs./ft. Wall thickness or guage No. SDR 11
 TYPE OF SCREEN OR PERFORATION MATERIAL:
 1 Steel 3 Stainless Steel 5 Fiberglass 8 RMP (SR) 10 Asbestos-Cement
 2 Brass 4 Galvanized Steel 6 Concrete tile 9 ABS 11 Other (Specify) _____
 12 None used (open hole)
 SCREEN OR PERFORATION OPENINGS ARE:
 1 Continuous slot 3 Mill slot 5 Gauzed wrapped 8 Saw cut 11 None (open hole)
 2 Louvered shutter 4 Key punched 6 Wire wrapped 9 Drilled holes
 7 Torch cut 10 Other (specify) _____ ft.
 SCREEN-PERFORATED INTERVALS: From _____ ft. to _____ ft., From _____ ft. to _____ ft.
 GRAVEL PACK INTERVALS: From _____ ft. to _____ ft., From _____ ft. to _____ ft.

6 GROUT MATERIAL: 1 Neat cement 2 Cement grout 3 Bentonite 4 Other _____
 Grout Intervals: From 4 ft. to 240 ft., From _____ ft. to _____ ft., From _____ ft. to _____ ft.
 What is the nearest source of possible contamination:
 1 Septic tank 4 Lateral lines 7 Pit privy 11 Fuel storage 14 Abandoned water well
 2 Sewer lines 5 Cess pool 8 Sewage lagoon 12 Fertilizer storage 16 Other (specify below)
 3 Watertight sewer lines 6 Seepage pit 9 Feedyard 13 Insecticide storage HOUSE
 Direction from well? WEST How many feet? 10

FROM	TO	LITHOLOGIC LOG	FROM	TO	PLUGGING INTERVALS
0	2	LIMESTONE	195	200	LIMESTONE
2	4	SHALE, BROWN	200	215	SHALE, GRAY
4	8	LIMESTONE	215	218	LIMESTONE
8	44	SHALE, BROWN, GRAY, RED	218	240	SHALE, GRAY
44	45	LIMESTONE			
45	92	SHALE, GRAY			
92	94	LIMESTONE			
94	102	SHALE, GRAY TO RED			3-240
102	107	LIMESTONE			2-230
107	138	SHALE, BROWN TO GRAY			1-248
138	141	LIMESTONE			1-246
141	145	SHALE, BROWN			
145	152	LIMESTONE			
152	195	SHALE, GRAY			

7 CONTRACTOR'S OR LANDOWNER'S CERTIFICATION: This ~~water~~ well was constructed, (2) reconstructed, or (3) plugged under my jurisdiction and was completed on (mo/day/year) 1/6/03 and this record is true to the best of my knowledge and belief. Kansas Water Well Contractor's Licence No. 585 This Water Well Record was completed on (mo/day/yr) 2/3/03 under the business name of ASSOCIATED WATERWELL MANAGER INC by (signature) [Signature]