


1	LOCATION OF WATER WELL: County: <u>Riley</u>	Fraction <u>SW¹/₄ SW¹/₄ NE¹/₄</u>	Section <u>27</u>	Number	Township <u>10s</u>	Number	Range <u>7E</u>	Number
---	---	--	----------------------	--------	------------------------	--------	--------------------	--------

Distance and direction from nearest town or city street address of well if located within city?
1 mile southwest of Manhattan

2 WATER WELL OWNER: Stagg Hill Golf Club
 RR #, St. Address, Box #: 4441 Fort Riley Blvd
 City, State, ZIP Code: Manhattan, KS 66502
 Board of Agriculture, Division of Water Resources
 Application Number: _____

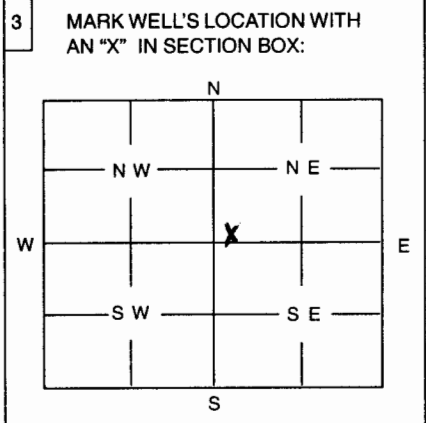

4 DEPTH OF WELL 50 ft
 WELL'S STATIC WATER LEVEL 19 ft.
 WELL WAS USED AS:
 1 Domestic 5 Public Water Supply 9 Dewatering
 2 Irrigation 6 Oil Field Water Supply 10 Monitoring Well
 3 Feedlot 7 Domestic (Lawn & Garden) 11 Injection Well
 4 Industrial 8 Air Conditioning 12 Other

Was a chemical / bacteriological sample submitted to Department? Yes No X
 If yes, mo/day/yr sample was submitted

Water Well Disinfected: Yes X No

5 TYPE OF BLANK CASING USED:
1 Steel 3 RMP (SR) 5 Wrought 7 Fiberglass 9 Other (Specify below)
2 PVC 4 ABS 6 Asbestos-Cement 8 Concrete Tile

Blank casing diameter 12/8 in. Was casing pulled? Yes No X If yes, how much

Casing height above or below land surface 22 in.

6 GROUT PLUG MATERIAL: 1 Neat cement 2 Cement grout 3 Bentonite 4 Other

Grout Plug Intervals: From 0 ft. to 50 ft., From ft. to ft., From to ft.

What is the nearest source of possible contamination:
 1 Septic tank 6 Seepage pit 11 Fuel storage
 2 Sewer lines 7 Pit privy 12 Fertilizer storage
 3 Watertight sewer lines 8 Sewage lagoon 13 Insecticide storage
 4 Lateral lines 9 Feedyard 14 Abandoned water well
 5 Cess Pool 10 Livestock pens 15 Oil well/Gas well

Direction from well? West How many feet? 150

FROM	TO	PLUGGING MATERIALS
<u>+22"</u>	<u>0</u>	<u>cement</u>
<u>0</u>	<u>50</u>	<u>Bentonite chips 3/8</u>

This well originally had 12" steel casing with concrete grout. Later someone had relined it with 8" pvc

7 CONTRACTOR'S OR LANDOWNER'S CERTIFICATION: This water well was plugged under my jurisdiction and was completed on (mo/day/year) May 5 - 2009 and this record is true to the best of my knowledge and belief. Kansas Water Well Contractor's License No. 182 This Water Well Record was completed on (mo/day/year) May 6 - 2009 under the business name of Strader Drilling Co Inc by (signature) [Signature]

INSTRUCTIONS: Use typewriter or ball point pen. Please press firmly and print clearly. Please fill in blanks, underline or circle the correct answers. Send top three copies to Kansas Department of Health and Environment, Bureau of Water, Topeka, Kansas 66620-0001. Telephone: 785/296-3565. Send one to Water Well Owner and retain one for your records.