

CORRECTION(S) TO WATER WELL RECORD (WWC-5)
(to rectify lacking or incorrect information)

County: Riley

Location listed as:

Location changed to:

Section-Township-Range: 11-11S-11E

14-10S-7E

Fraction (1/4 1/4 1/4): SE SE SE

SW SE SE SW

Other changes: Initial statements: Lat.: 39.1030, Long.: 96.3770

Changed to: Lat.: 39.175203, Long.: 96.618966

Comments: Lat./Long. taken from Google Earth.

verification method: Phone call to well contractor, Well site address, city street map, latitude & longitude, KGS' "LEO" conversion tool, and mapping tool on KGS website. initials: DR date: 7/29/2010

submitted by: Kansas Geological Survey, Data Resources Library, 1930 Constant Ave., Lawrence, KS 66047-3726
to: Kansas Dept of Health & Environment, Bureau of Water, 1000 SW Jackson, Suite 420, Topeka, KS 66612-1367.

WATER WELL RECORD


Form WWC-5

Division of Water Resources; App. No.

1 LOCATION OF WATER WELL: County: Riley, Fraction: SW 1/4 SE 1/4 SW 1/4, Section Number: 11, Township Number: T 11 S, Range Number: R 11 E

Distance and direction from nearest town or city street address of well if located within city? 3800 Bradford Terrace, Global Positioning Systems (decimal degrees, min. of 4 digits) Latitude: 39.1030, Longitude: 96.3770

2 WATER WELL OWNER: GROUND SOURCE, INC., RR#, St. Address, Box #: 216 E. 5th St, City, State, ZIP Code: Holton, KS - 66436, Elevation: , Datum: , Data Collection Method:

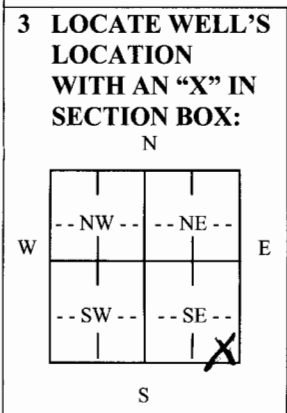

3 LOCATE WELL'S LOCATION WITH AN 'X' IN SECTION BOX: N, S, E, W, 4 DEPTH OF COMPLETED WELL: 160 ft., Depth(s) Groundwater Encountered (1) ft., (2) ft., (3) ft., WELL'S STATIC WATER LEVEL: ft. below land surface measured on mo/day/yr: , Pump test data: Well water was ft. after hours pumping gpm, Est. Yield: gpm: Well water was ft. after hours pumping gpm, WELL WATER TO BE USED AS: 5 Public water supply, 8 Air conditioning, 11 Injection well, 1 Domestic, 3 Feedlot, 6 Oil field water supply, 9 Dewatering, 12 Other (Specify below) CLOSED LOOP Geothermal, 2 Irrigation, 4 Industrial, 7 Domestic (lawn & garden), 10 Monitoring well, Was a chemical/bacteriological sample submitted to Department? Yes No X, Sample was submitted. Water well disinfected? Yes No X

5 TYPE OF CASING USED: 1 Steel, 3 RMP (SR), 6 Asbestos-Cement, 9 Other (specify below) HDPE, 2 PVC, 4 ABS, 7 Fiberglass, CASING JOINTS: Glued, Clamped, Welded X, Threaded, Blank casing diameter: 3/4 in. to 160 ft., Diameter: in. to ft., Diameter: in. to ft., Casing height: 48 in., Weight: lbs./ft., Wall thickness or gauge No. SDR11, TYPE OF SCREEN OR PERFORATION MATERIAL: 1 Steel, 3 Stainless Steel, 5 Fiberglass, 7 PVC, 9 ABS, 11 Other (Specify) , 2 Brass, 4 Galvanized Steel, 6 Concrete tile, 8 RM (SR), 10 Asbestos-Cement, 12 None used (open hole), SCREEN OR PERFORATION OPENINGS ARE: 1 Continuous slot, 3 Mill slot, 5 Gauzed wrapped, 7 Torch cut, 9 Drilled holes, 11 None (open hole), 2 Louvered shutter, 4 Key punched, 6 Wire wrapped, 8 Saw cut, 10 Other (specify) , SCREEN-PERFORATED INTERVALS: From ft. to ft., From ft. to ft., From ft. to ft., GRAVEL PACK INTERVALS: From ft. to ft., From ft. to ft., From ft. to ft.

6 GROUT MATERIAL: 1 Neat cement, 2 Cement grout, 3 Bentonite, 4 Other, Grout Intervals: From 4 ft. to 160 ft., From ft. to ft., From ft. to ft., What is the nearest source of possible contamination: 1 Septic tank, 4 Lateral lines, 7 Pit privy, 10 Livestock pens, 13 Insecticide storage, 6 Other (specify below) HOUSE, 2 Sewer lines, 5 Cess pool, 8 Sewage lagoon, 11 Fuel storage, 14 Abandoned water well, 3 Watertight sewer lines, 6 Seepage pit, 9 Feedyard, 12 Fertilizer storage, 15 Oil well/gas well, Direction from well? SOUTH, How many feet? 15

Table with 2 main columns: LITHOLOGIC LOG and PLUGGING INTERVALS. LITHOLOGIC LOG: FROM TO DESCRIPTION (0-25 CLAYEY SALT TRAP SAND, 25-30 LIMESTONE, 30-55 SHALE GRAY, 55-62 LIMESTONE, 62-77 SHALE GRAY, 77-78 LIMESTONE, 78-80 VOID, 80-85 LIMESTONE, 85-107 SHALE GRAY, 107-115 LIMESTONE). PLUGGING INTERVALS: FROM TO DESCRIPTION (115-142 SHALE GRAY, 142-160 LIMESTONE), 4 HOLES TO 160.

7 CONTRACTOR'S OR LANDOWNER'S CERTIFICATION: This water well was constructed, reconstructed, or plugged under my jurisdiction and was completed on (mo/day/year) 10/20/08 and this record is true to the best of my knowledge and belief. Kansas Water Well Contractor's License No. 760, This Water Well Record was completed on (mo/day/year) 11/31/09 under the business name of ASSUMED DRILLING INC by (signature) L. [Signature]

INSTRUCTIONS: Use typewriter or ball point pen. PLEASE PRESS FIRMLY and PRINT clearly. Please fill in blanks, underline or circle the correct answers. Send top three copies to Kansas Department of Health and Environment, Bureau of Water, Geology Section, 1000 SW Jackson St., Suite 420, Topeka, Kansas 66612-1367. Telephone 785-296-5522. Send one to WATER WELL OWNER and retain one for your records. Fee of \$5.00 for each constructed well. Visit us at http://www.kdheks.gov/waterwell/index.html.