


WATER WELL RECORD

Form WWC-5

Division of Water Resources App. No. []

1 LOCATION OF WATER WELL: County: Riley Fraction 1/4 SW 1/4 SE 1/4 SE 1/4 Section Number 22 Township No. T 10 S Range Number R 7 E W
Street/Rural Address of Well Location; if unknown, distance & direction from nearest town or intersection: If at owner's address, check here [] 1/2 mile West of Manhattan, KS
Global Positioning System (GPS) information: Latitude: Longitude: Elevation: Datum: Collection Method: Est. Accuracy:

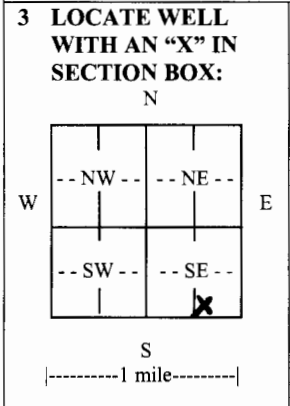

2 WATER WELL OWNER: Walters-Morgan Construction RR#, Street Address, Box #: 2616 Tuttle Creek Blvd. City, State, ZIP Code : Manhattan, KS 66502-4479
3 LOCATE WELL WITH AN "X" IN SECTION BOX:
4 DEPTH OF COMPLETED WELL 55 ft. Depth(s) Groundwater Encountered (1) (2) (3) WELL'S STATIC WATER LEVEL 15 ft. below land surface measured on mo/day/yr. 8/16/11 Pump test data: Well water was EST. YIELD 1500 gpm. Well water was Bore Hole Diameter 30 in. to 55 ft., and WELL WATER TO BE USED AS: [] Public water supply [] Geothermal [] Injection well [] Domestic [] Feedlot [] Oil field water supply [X] Dewatering [] Other (Specify below) [] Irrigation [] Industrial [] Domestic-lawn & garden [] Monitoring well Was a chemical/bacteriological sample submitted to Department? [] Yes [X] No If yes, mo/day/yr sample was submitted. Water well disinfected? [X] Yes [] No

5 TYPE OF CASING USED: [] Steel [X] PVC [] Other CASING JOINTS: [X] Glued [] Clamped [] Welded [] Threaded Casing diameter 16 in. to 25 ft., Diameter Casing height above land surface 12 in., Weight 16.15 lbs./ft., Wall thickness or gauge No. 500 TYPE OF SCREEN OR PERFORATION MATERIAL: [] Steel [] Stainless Steel [X] PVC [] Other (Specify) [] Brass [] Galvanized Steel [] None used (open hole) SCREEN OR PERFORATION OPENINGS ARE: [] Continuous slot [X] Mill slot [] Gauze wrapped [] Torch cut [] Drilled holes [] None (open hole) [] Louvered shutter [] Key punched [] Wire wrapped [] Saw cut [] Other (specify) SCREEN-PERFORATED INTERVALS: From 25 ft. to 55 ft., GRAVEL PACK INTERVALS: From 25 ft. to 55 ft.,

6 GROUT MATERIAL: [] Neat cement [] Cement grout [X] Bentonite [] Other Grout Intervals: From 5 ft. to 25 ft., What is the nearest source of possible contamination: [] Septic tank [] Lateral lines [] Pit privy [] Livestock pens [] Insecticide storage [] Other (specify below) [] Sewer lines [] Cesspool [] Sewage lagoon [] Fuel storage [] Abandoned water well [X] Watertight sewer lines [] Seepage pit [] Feedyard [] Fertilizer storage [] Oil well/gas well Direction from well North Distance from well 20 ft.

Table with 6 columns: FROM, TO, LITHOLOGIC LOG, FROM, TO, LITHO. LOG (cont.) or PLUGGING INTERVALS. Rows include: 0-2 Sandy topsoil, 2-10 Silt, tan, 10-35 Sand, fine to medium, 35-55 Sand, medium to coarse w/gravel.

7 CONTRACTOR'S OR LANDOWNER'S CERTIFICATION: This water well was [X] constructed, [] reconstructed, or [] plugged under my jurisdiction and was completed on (mo/day/year) 8/16/11 and this record is true to the best of my knowledge and belief. Kansas Water Well Contractor's License No. 138 This Water Well Record was completed on (mo/day/year) 8/29/11 under the business name of Peterson Irrigation, Inc. by (signature) Mike Peterson

INSTRUCTIONS: Use typewriter or ball point pen. PLEASE PRESS FIRMLY and PRINT clearly. Please fill in blanks and check the correct answers. Send three copies (white, blue, pink) to Kansas Department of Health and Environment, Bureau of Water, Geology Section, 1000 SW Jackson St., Suite 420, Topeka, Kansas 66612-1367. Telephone 785-296-5524. Send one copy to WATER WELL OWNER and retain one for your records. Include fee of \$5.00 for each constructed well. Visit us at http://www.kdheks.gov/waterwell/index.html.