

**WATER WELL RECORD Form WWC-5**


*Plugged*

Original Record  Correction  Change in Well Use

Division of Water Resources App. No.  Well ID

**1 LOCATION OF WATER WELL:** County: *Riley* Fraction: *SE 1/4 SE 1/4 NE 1/4* Section Number: *28* Township Number: *T 10S* Range Number: *R 7*  E  W

**2 WELL OWNER:** Last Name: *Burgkamp Const & Svc of KS* First: *Steve* Street or Rural Address where well is located (if unknown, distance and direction from nearest town or intersection): *Skylark Rd. New Project by Airport*  
 Business: *Burgkamp Const & Svc of KS* Address: *3709 S. West St* City: *Wichita* State: *KS* ZIP: *67217*

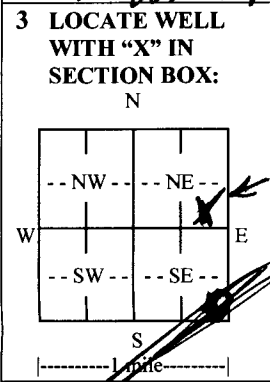

**4 DEPTH OF COMPLETED WELL:** *was 55'*  
 Depth(s) Groundwater Encountered: 1) ..... ft.  
 2) ..... ft. 3) ..... ft., or 4)  Dry Well  
 WELL'S STATIC WATER LEVEL: *was 19'*  
 below land surface, measured on (mo-day-yr) .....  
 above land surface, measured on (mo-day-yr) .....  
 Pump test data: Well water was ..... ft.  
 after ..... hours pumping ..... gpm  
 Well water was ..... ft.  
 after ..... hours pumping ..... gpm  
 Estimated Yield: ..... gpm  
 Bore Hole Diameter: ..... in. to ..... ft. and  
 ..... in. to ..... ft.

**5 Latitude:** ..... (decimal degrees)  
**Longitude:** ..... (decimal degrees)  
 Datum:  WGS 84  NAD 83  NAD 27  
 Source for Latitude/Longitude:  
 GPS (unit make/model: .....)  
 (WAAS enabled?  Yes  No)  
 Land Survey  Topographic Map  
 Online Mapper: .....  
**6 Elevation:** ..... ft.  Ground Level  TOC  
 Source:  Land Survey  GPS  Topographic Map  
 Other .....

**7 WELL WATER TO BE USED AS:**

1. Domestic:  Household  Lawn & Garden  Livestock  
 Irrigation *was*  
 Feedlot  Industrial

2.  Public Water Supply: well ID .....  
 Dewatering: how many wells? .....  
 Aquifer Recharge: well ID .....  
 Monitoring: well ID .....  
 Environmental Remediation: well ID .....  
 Air Sparge  Soil Vapor Extraction  
 Recovery  Injection

10.  Oil Field Water Supply: lease .....  
 11. Test Hole: well ID .....  
 Cased  Uncased  Geotechnical  
 12. Geothermal: how many bores? .....  
 a) Closed Loop  Horizontal  Vertical  
 b) Open Loop  Surface Discharge  Inj. of Water  
 13.  Other (specify): .....

Was a chemical/bacteriological sample submitted to KDHE?  Yes  No If yes, date sample was submitted: .....  
 Water well disinfected?  Yes  No

**8 TYPE OF CASING USED:**  Steel  PVC  Other *was CONCRETE* CASING JOINTS:  Glued  Clamped  Welded  Threaded  
 Casing diameter: *was 16"* in. to ..... ft. Diameter ..... in. to ..... ft., Diameter ..... in. to ..... ft.  
 Casing height above land surface: *was 3' below* ft. Weight ..... lbs./ft. Wall thickness or gauge No. ....  
 TYPE OF SCREEN OR PERFORATION MATERIAL:  
 Steel  Stainless Steel  Fiberglass  PVC  
 Brass  Galvanized Steel  Concrete tile  None used (open hole)  Other (Specify) .....  
 SCREEN OR PERFORATION OPENINGS ARE:  
 Continuous Slot  Mill Slot  Gauze Wrapped  Torch Cut  Drilled Holes  Other (Specify) .....  
 Louvered Shutter  Key Punched  Wire Wrapped  Saw Cut  None (Open Hole)  
 SCREEN-PERFORATED INTERVALS: From ..... ft. to ..... ft., From ..... ft. to ..... ft., From ..... ft. to ..... ft.  
 GRAVEL PACK INTERVALS: From *25'* ft. to *55'* ft., From ..... ft. to ..... ft., From ..... ft. to ..... ft.

**9 GROUT MATERIAL:**  Neat cement  Cement grout  Bentonite  Other .....  
 Grout Intervals: From *3'* ft. to *25'* ft., From ..... ft. to ..... ft., From ..... ft. to ..... ft.  
 Nearest source of possible contamination:  
 Septic Tank  Lateral Lines *was None Close*  Pit Privy  Livestock Pens  Insecticide Storage  
 Sewer Lines  Cess Pool  Sewage Lagoon  Fuel Storage  Abandoned Water Well  
 Watertight Sewer Lines  Seepage Pit  Feedyard  Fertilizer Storage  Oil Well/Gas Well  
 Other (Specify) .....

Direction from well? ..... Distance from well? ..... ft.

10 FROM	TO	LITHOLOGIC LOG	FROM	TO	LITHO. LOG (cont.) or PLUGGING INTERVALS
<i>0</i>	<i>3</i>	<i>Completed clay</i>			
<i>3</i>	<i>25</i>	<i>Bacteriic Grout</i>			
<i>25</i>	<i>55</i>	<i>Charakter Sand/Gravel</i>			

Notes: *Plugged*

**11 CONTRACTOR'S OR LANDOWNER'S CERTIFICATION:** This water well was  constructed,  reconstructed, or  plugged under my jurisdiction and was completed on (mo-day-year) *4/18/2019* and this record is true to the best of my knowledge and belief.  
 Kansas Water Well Contractor's License No. *45* This Water Well Record was completed on (mo-day-year) *4/24/2019*  
 under the business name of *Haldeman Well Drilling*