


LOCATION OF WATER WELL: Fraction Sec 1/4 MAP 1/4 Section Number 36 Township Number T 10 S Range Number R 7 E/W

Distance and direction from nearest town or city street address of well if located within city? Riley Co Rd 13-88 Sec 1/4 MAP Riley Co Landfill

WATER WELL OWNER: Riley Co. Board of Agriculture, Division of Water Resources
 R#, St. Address, Box #: MANHATTAN Application Number:

LOCATE WELL'S LOCATION WITH AN "X" IN SECTION BOX: INE DEPTH OF COMPLETED WELL: 40 ft. ELEVATION: _____

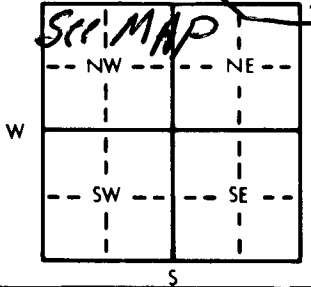

Depth(s) Groundwater Encountered 1. 16 ft. 2. _____ ft. 3. _____ ft.
 WELL'S STATIC WATER LEVEL 16 ft. below land surface measured on mo/day/yr _____
 Pump test data: Well water was _____ ft. after _____ hours pumping _____ gpm
 Est. Yield 40 gpm: Well water was _____ ft. after _____ hours pumping _____ gpm
 Bore Hole Diameter 6 in. to 40 ft., and _____ in. to _____ ft.
 WELL WATER TO BE USED AS: 5 Public water supply 8 Air conditioning 11 Injection well
 1 Domestic 3 Feedlot 6 Oil field water supply 9 Dewatering 12 Other (Specify below) Monitoring
 2 Irrigation 4 Industrial 7 Lawn and garden only 10 Observation well
 Was a chemical/bacteriological sample submitted to Department? Yes _____ No _____; If yes, mo/day/yr sample was submitted _____
 Water Well Disinfected? Yes _____ No ✓

TYPE OF BLANK CASING USED: 1 Steel 3 RMP (SR) 5 Wrought iron 8 Concrete tile CASING JOINTS: Glued _____ Clamped _____
2 PVC 4 ABS Flush Joint 6 Asbestos-Cement 9 Other (specify below) Welded _____
 7 Fiberglass Threaded ✓

Blank casing diameter 4 in. to 30 ft., Dia. _____ in. to _____ ft., Dia. _____ in. to _____ ft.
 Casing height above land surface 3 in., weight 200 lb lbs./ft. Wall thickness or gauge No. _____

TYPE OF SCREEN OR PERFORATION MATERIAL: 7 PVC 10 Asbestos-cement
 1 Steel 3 Stainless steel 5 Fiberglass 8 RMP (SR) 11 Other (specify) _____
 2 Brass 4 Galvanized steel 6 Concrete tile 9 ABS 12 None used (open hole)

SCREEN OR PERFORATION OPENINGS ARE: 16 5 Gauzed wrapped 8 Saw cut 11 None (open hole)
1,000's 3 Mill slot 6 Wire wrapped 9 Drilled holes
 1 Continuous slot 4 Key punched 7 Torch cut 10 Other (specify) _____
 2 Louvered shutter

SCREEN-PERFORATED INTERVALS: From 30 ft. to 40 ft., From _____ ft. to _____ ft.
 From _____ ft. to _____ ft., From _____ ft. to _____ ft.

GRAVEL PACK INTERVALS: From 10 ft. to 40 ft., From _____ ft. to _____ ft.
 From _____ ft. to _____ ft., From _____ ft. to _____ ft.

GROUT MATERIAL: 1 Neat cement 2 Cement grout 3 Bentonite 4 Other _____
 Grout Intervals: From 0 ft. to 10 ft., From _____ ft. to _____ ft., From _____ ft. to _____ ft.

What is the nearest source of possible contamination: 10 Livestock pens 14 Abandoned water well
 1 Septic tank 4 Lateral lines 7 Pit privy 11 Fuel storage 15 Oil well/Gas well
 2 Sewer lines 5 Cess pool 8 Sewage lagoon 12 Fertilizer storage 16 Other (specify below)
 3 Watertight sewer lines 6 Seepage pit 9 Feedyard 13 Insecticide storage

Direction from well?		LITHOLOGIC LOG		LITHOLOGIC LOG	
FROM	TO	FROM	TO	FROM	TO
0	35	FINISH SAND			
35	40	MEDIUM SAND			
0	15	CLAY			
15	20	FINISH COURSE SAND			
20	40	COURSE SAND			

CONTRACTOR'S OR LANDOWNER'S CERTIFICATION: This water well was (1) constructed, (2) reconstructed, or (3) plugged under my jurisdiction and was completed on (mo/day/year) 9/16/86 and this record is true to the best of my knowledge and belief. Kansas Water Well Contractor's License No. 451 This Water Well Record was completed on (mo/day/yr) 1/10/87
 Under the business name of Haldeman Well Drilling by (signature) Craig Haldeman
 INSTRUCTIONS: Use typewriter or ball point pen, PLEASE PRESS FIRMLY and PRINT clearly. Please fill in blanks, underline or circle the correct answers. Send top three copies to Kansas Department of Health and Environment, Division of Environment, Environmental Geology Section, Topeka, KS 66620. Send one to WATER WELL OWNER and retain one for your records.