

WATER WELL PLUGGING RECORD Form WWC-5P KSA 82a-1212 ID NO.


JCI North 3-1

1 LOCATION OF WATER WELL: Fraction 1/4 NE 1/4 SW 1/4 NE 1/4 Section Number 12 Township Number T 10 S Range Number 07 E W
 County: Riley

Street/Rural Address of Well Location; if unknown, distance & direction from nearest town or intersection: If at owner's address, check here Approximately 150 ft north of Track&Field northern building on Kansas State University property.

Global Positioning Systems (GPS) information:
 Latitude: 39.199685 (in decimal degrees)
 Longitude: 96.595229 (in decimal degrees)
 Elevation: 1120
 Horizontal Datum: WGS84, NAD83, NAD27
 Collection Method:
 GPS unit (Make/Model: _____)
 Digital Map/Photo, Topographic Map, Land Survey
 Est. Accuracy: < 3 m, 3-5 m, 5-15 m, > 15 m

2 WATER WELL OWNER: Johnson Controls
 RR#, St. Address, Box #: 1514 SW 41st
 City, State ZIP Code: Topeka, KS 66609

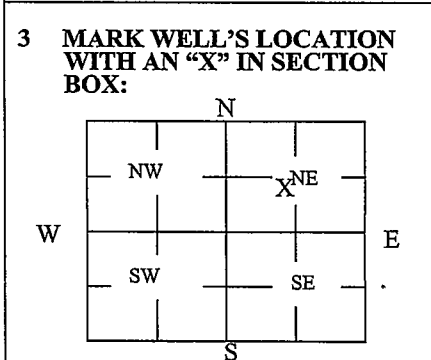

4 DEPTH OF WELL 103 ft.
 WELL'S STATIC WATER LEVEL 35.14 ft
 WELL WAS USED AS:
 Domestic Public Water Supply Dewatering
 Irrigation Oil Field Water Supply Monitoring
 Feedlot Domestic (Lawn & Garden) Injection Well
 Industrial Air Conditioning Other Test Well South
 Was a chemical/bacteriological sample submitted to Department? Yes No

5 TYPE OF BLANK CASING USED:
 Steel RMP (SR) Wrought Fiberglass Other (Specify below)
 PVC ABS Asbestos-Cement Concrete Tile
 Blank casing diameter 5 in. Was casing pulled? Yes No If yes, how much 3 feet
 Casing height above or below and surface 36 in.

6 GROUT PLUG MATERIAL: Neat cement Cement grout ² Bentonite ¹ Other Chlorinated Sand
 Grout Plug Intervals: ¹ From 103 ft. to 34 ft., ² From 34 ft. to 3 ft., From _____ ft. to _____ ft.
 What is the nearest source of possible contamination:
 Septic tank Seepage pit Fuel storage Other (specify below) Drain
 Sewer lines Pit privy Fertilizer storage
 Watertight sewer lines Sewage lagoon Insecticide storage
 Lateral lines Feedyard Abandoned water well Direction from well? West
 Cess pool Livestock pens Oil well/Gas well How many feet? 15

| FROM | TO | PLUGGING MATERIALS | FROM | TO | PLUGGING MATERIALS |
|------|-----|--------------------------|------|----|--------------------|
| 3 | 34 | Hydrated Bentonite Chips | | | |
| 34 | 103 | Chlorinated Sand | | | |
| | | | | | |
| | | | | | |
| | | | | | |

7 CONTRACTOR'S OR LANDOWNER'S CERTIFICATION: This water well was plugged under my jurisdiction and was completed on (mo/day/year) 12/23/2021 and this record is true to the best of my knowledge and belief. Kansas Water Well Contractor's License No. 585. This Water Well Record was completed on (mo/day/year) 1/3/2022 under the business name of Associated Environmental, Inc. by (signature) [Signature]

Send one white copy to Kansas Department of Health & Environment, Geology Section, 1000 SW Jackson Street, Ste. 420, Topeka, KS 66612-1367. Send one copy to WATER WELL OWNER and retain one for your records.
 Visit us at <http://www.kdheks.gov/waterwell/index.html> Telephone 785-296-5524.