

WATER WELL PLUGGING RECORD Form WWC-5P

KSA 82a-1212 ID NO.

JCI South 3-1


1 **LOCATION OF WATER WELL:** Fraction 1/4 NE 1/4 SW 1/4 NE 1/4 Section Number 12 Township Number T 10 S Range Number 07 E W
 County: Riley

Street/Rural Address of Well Location; if unknown, distance & direction from nearest town or intersection: If at owner's address, check here Approximately 150 ft north of Track&Field northern building on Kansas State University property.

Global Positioning Systems (GPS) information:
 Latitude: 39.199671 (in decimal degrees)
 Longitude: 96.595221 (in decimal degrees)
 Elevation: 1120
 Horizontal Datum: WGS84, NAD83, NAD27
 Collection Method:

2 **WATER WELL OWNER:** Johnson Controls
 RR#, St. Address, Box # 1514 SW 41st
 City, State ZIP Code Topeka, KS 66609

GPS unit (Make/Model: _____)
 Digital Map/Photo, Topographic Map, Land Survey
 Est Accuracy <3 m, 3-5 m, 5-15 m, >15 m

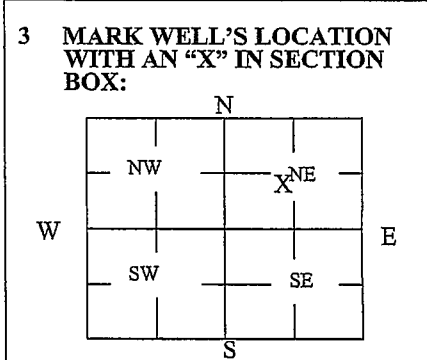

4 **DEPTH OF WELL** 74.30 ft.
 WELL'S STATIC WATER LEVEL 28.57 ft.
 WELL WAS USED AS:

Domestic Public Water Supply Dewatering
 Irrigation Oil Field Water Supply Monitoring
 Feedlot Domestic (Lawn & Garden) Injection Well
 Industrial Air Conditioning Other Test Well South

Was a chemical/bacteriological sample submitted to Department? Yes No

5 **TYPE OF BLANK CASING USED:**

Steel RMP (SR) Wrought Fiberglass Other (Specify below) _____
 PVC ABS Asbestos-Cement Concrete Tile

Blank casing diameter 5 in. Was casing pulled? Yes No If yes, how much 3 feet
 Casing height above or below and surface 36 in.

6 **GROUT PLUG MATERIAL:** Neat cement Cement grout ² Bentonite ¹ Other Chlorinated Sand

Grout Plug Intervals: ¹ From 74.30 ft. to 28 ft., ² From 28 ft. to 3 ft., From _____ ft. to _____ ft.

What is the nearest source of possible contamination:

Septic tank Seepage pit Fuel storage Other (specify below) Drain
 Sewer lines Pit privy Fertilizer storage
 Watertight sewer lines Sewage lagoon Insecticide storage
 Lateral lines Feedyard Abandoned water well Direction from well? West
 Cess pool Livestock pens Oil well/Gas well How many feet? 15

FROM	TO	PLUGGING MATERIALS	FROM	TO	PLUGGING MATERIALS
3	28	Hydrated Bentonite Chips			
28	74.30	Chlorinated Sand			

7 **CONTRACTOR'S OR LANDOWNER'S CERTIFICATION:** This water well was plugged under my jurisdiction and was completed on (mo/day/year) 12/23/2021 and this record is true to the best of my knowledge and belief. Kansas Water Well Contractor's License No. 585. This Water Well Record was completed on (mo/day/year) 1/3/2022 under the business name of Associated Environmental, Inc. by (signature) [Signature]

Send one white copy to Kansas Department of Health & Environment, Geology Section, 1000 SW Jackson Street, Ste. 420, Topeka, KS 66612-1367. Send one copy to WATER WELL OWNER and retain one for your records.
 Visit us at <http://www.kdheks.gov/waterwell/index.html> Telephone 785-296-5524.



North Well

South Well

MCM KSU Well Plugging
12/23/2021