

**WATER WELL PLUGGING RECORD Form WWC-5P KSA 82a-1212 ID NO.**


**MW8**

**1 LOCATION OF WATER WELL:**  
 County: Riley      Fraction: SW¼ SE¼ SW¼ SE¼      Section Number: 11      Township Number: T 10 S      Range Number: 7  E  W

Street/Rural Address of Well Location: if unknown, distance & direction from nearest town or intersection: If at owner's address, check here   
 ~150' southeast of 3108 Anderson, Manhattan, KS

**Global Positioning Systems (GPS) information:**  
 Latitude: NA (in decimal degrees)  
 Longitude: NA (in decimal degrees)  
 Elevation: \_\_\_\_\_  
 Horizontal Datum:  WGS84,  NAD83,  NAVD27  
 Collection Method:  
 GPS unit (Make/model: \_\_\_\_\_)  
 Digital Map/Photo,  Topographic Map,  Land Survey  
 Est. Accuracy:  <3 m,  3-5 m,  5-15 m,  >15 m

**2 WATER WELL OWNER:** Shop Quik Stores, LLC  
 RR#, St. Address, Box #: P.O. Box 548  
 City, State ZIP Code: Manhattan, KS 66502

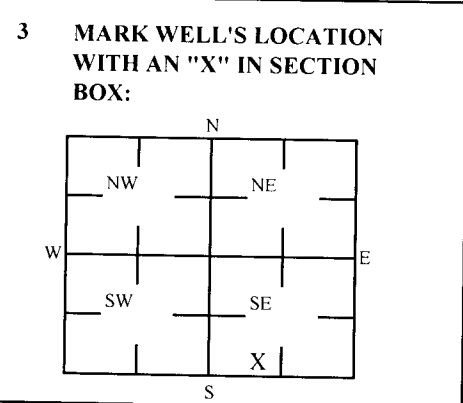

**4 DEPTH OF WELL** 18.2 ft. MW8  
 WELL'S STATIC WATER LEVEL \_\_\_\_\_ ft  
 WELL WAS USED AS:  
 Domestic       Public Water Supply       Dewatering  
 Irrigation       Oil Field Water Supply       Monitoring  
 Feedlot       Domestic (Lawn & Garden)       Injection Well  
 Industrial       Air Conditioning       Other \_\_\_\_\_  
 Was a chemical/bacteriological sample submitted to Department?      Yes  No

**5 TYPE OF BLANK CASING USED:**  
 Steel       RMP (SR)       Wrought       Fiberglass       Other (Specific below)  
 PVC       ABS       Asbestos-Cement       Concrete Tile  
 Blank casing diameter 2 in.      Was casing pulled? Yes  No       If yes, how much 1 ft  
 Casing height above or below land surface NA in.

**6 GROUT PLUG MATERIAL:**  Neat cement       Cement grout       Bentonite       Other Asphalt: 0-0.5'; Soil: 0.5-3'  
 Grout Plug Intervals: From 3 ft to 18.2 ft, From \_\_\_\_\_ ft to \_\_\_\_\_ ft, From \_\_\_\_\_ ft to \_\_\_\_\_ ft.  
 What is the nearest source of possible contamination:  
 Septic tank       Seepage pit       Fuel storage       Other (specify below) \_\_\_\_\_  
 Sewer lines       Pit privy       Fertilizer storage  
 Watertight sewer lines       Sewage lagoon       Insecticide storage  
 Lateral lines       Feed yard       Abandoned water well  
 Cess pool       Livestock pens       Oil well/Gas well  
 Direction from well? \_\_\_\_\_  
 How many feet? \_\_\_\_\_

FROM	TO	PLUGGING MATERIALS	FROM	TO	PLUGGING MATERIALS
0	0.5	Asphalt			
0.5	3	Soil			
3	18.2	Bentonite			

KDHE ID: Shop Quik #11: U5-081-13896

**7 CONTRACTOR'S OR LANDOWNER'S CERTIFICATION:** This water well was plugged under my jurisdiction and was completed on (mo/day/year) 8/11/22 and this record is true to the best of my knowledge and belief. Kansas Water Contractor's License No. 757. This Water Well Record was completed on (mo/day/year) 8/17/22 under the business name of Larsen & Associates, Inc. By (signature) \_\_\_\_\_

Send one white copy to Kansas Department of Health & Environment, Geology Section, 1000 SW Jackson Street, Ste. 420, Topeka, KS 66612-1367. Send one copy to WATER WELL OWNER and retain one for your records  
 Visit us at <http://www.kdheks.gov/waterwell/index.html> Telephone 785-296-5524.

NOTE: Figures exhibited within this report are only to be used within the context of this report. Placement of property lines, wells, structures, and roads is based on the available information from county appraiser maps, surveys, site visits, and/or previous vendor reports and should be considered approximate.

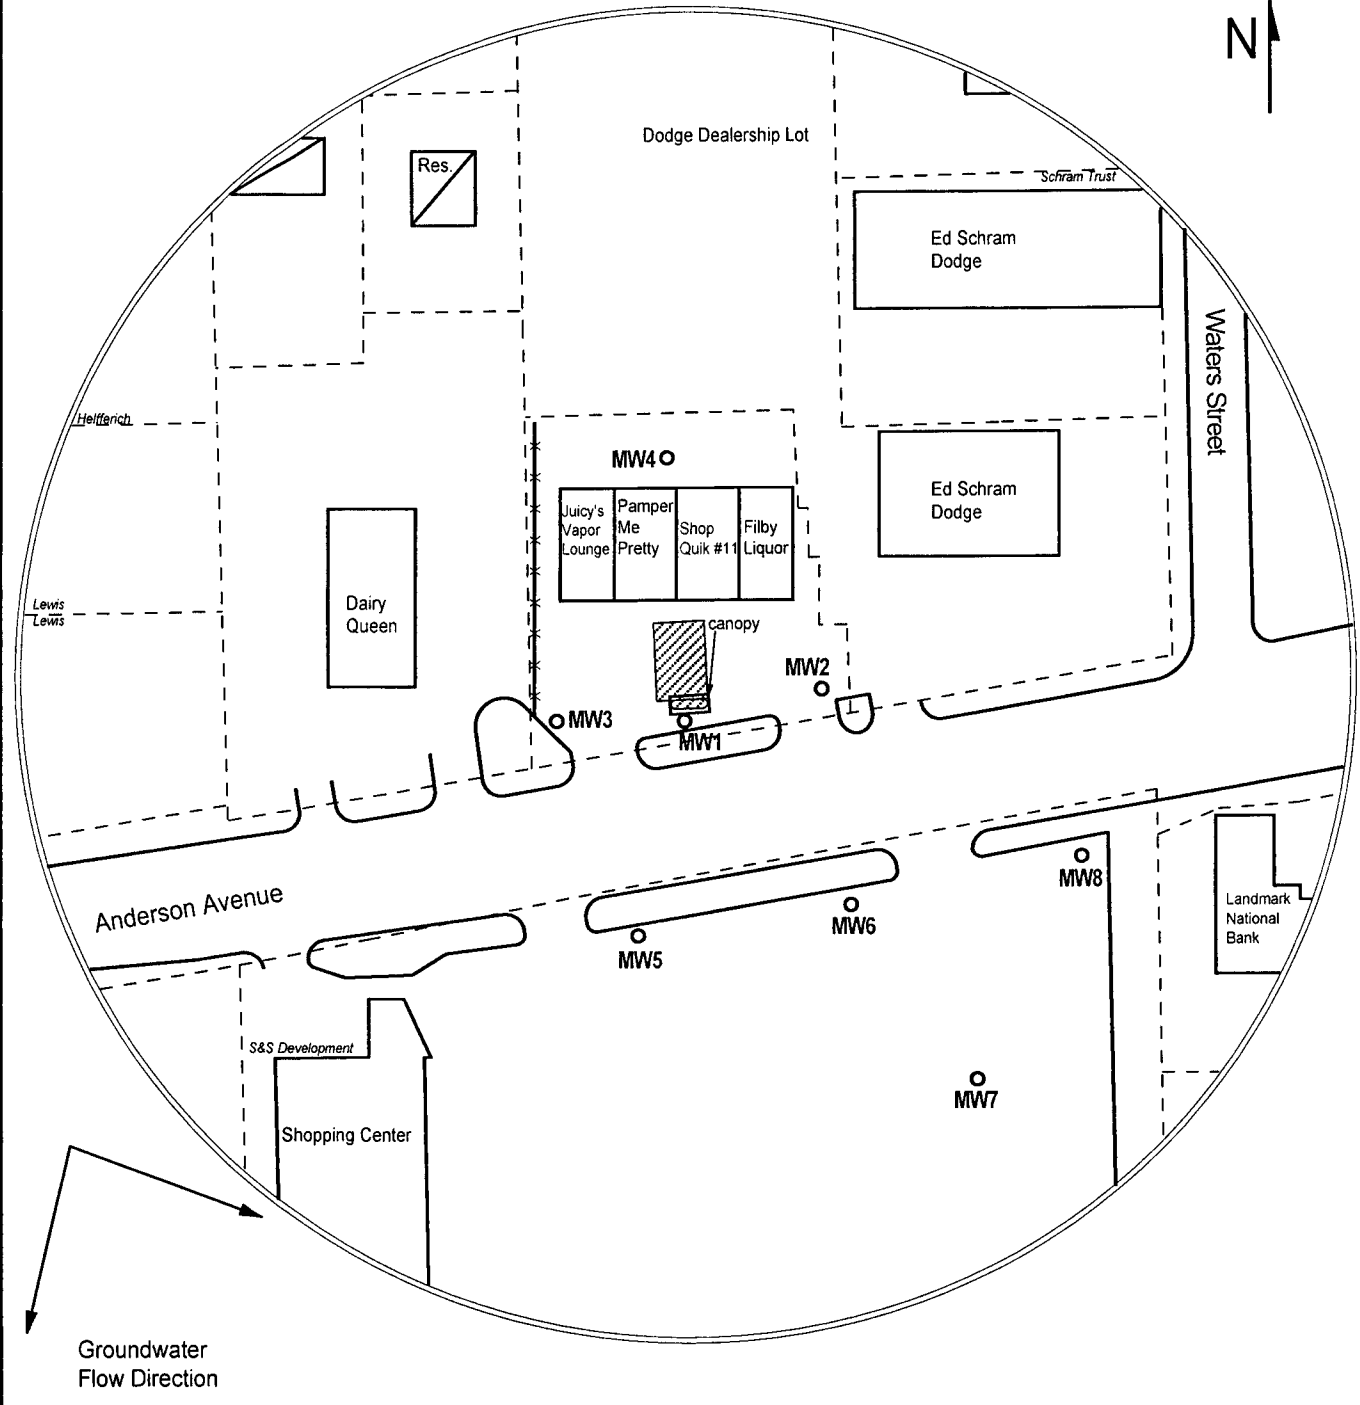






FIGURE 1 - 350 FT RADIUS AREA BASE MAP

**LEGEND:**

-  Approximate Location of Active UST Basin and Pump Islands
-  Approximate Location of Property Lines
-  Building with Basement
-  Plugged Monitoring Well



**PROJECT:**  
 Shop Quik #11  
 3108 Anderson  
 Manhattan, KS  
 KDHE ID: U5-081-13896  
 Date: 8/10-11/22



1311 E 25th St., Suite B (785) 841-8707 office  
 Lawrence, KS 66046 (785) 865-4282 fax

NOTE: Utility depths and locations are approximate.