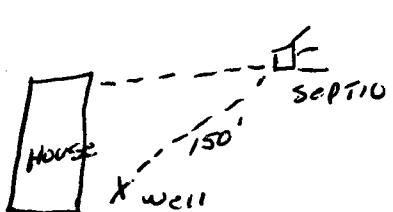


USE TYPEWRITER OR BALL POINT PEN-PRESS FIRMLY, PRINT CLEARLY.

WATER WELL RECORD
KSA 82a-1201-1215

Kansas Department of Health and Environment-Division of Environment
(Water well Contractors)
Topeka, Kansas 66620

1. Location of well:	County Riley	Fraction NE 1/4 NE 1/4 NE 1/4	Section number 2	Township number T 10 S R 7 E	Range number
2. Distance and direction from nearest town or city: 1 N of Street address of well location if in city: MANHATTAN			3. Owner of well: WILFORD BROOKS R.R. or street: CIRCLE RD. RT. 4 City, state, zip code: MANHATTAN, KS 66502		
4. Locate with "X" in section below: N W E S 1 Mile			Sketch map: 		
5. Type and color of material			6. Bore hole dia. 8 in. Completion date 9-12-78 Well depth 120 ft.		
			7. <input type="checkbox"/> Cable tool <input checked="" type="checkbox"/> Rotary <input type="checkbox"/> Driven <input type="checkbox"/> Dug <input type="checkbox"/> Hollow rod <input type="checkbox"/> Jetted <input type="checkbox"/> Bored <input type="checkbox"/> Reverse rotary		
			8. Use: <input checked="" type="checkbox"/> Domestic <input type="checkbox"/> Public supply <input type="checkbox"/> Industry <input type="checkbox"/> Irrigation <input type="checkbox"/> Air conditioning <input type="checkbox"/> Stock <input type="checkbox"/> Lawn <input type="checkbox"/> Oil field water <input type="checkbox"/> Other		
			9. Casing: Material PVC Height Above or below Threaded <input type="checkbox"/> Welded <input type="checkbox"/> Surface 29 in. RMP <input type="checkbox"/> PVC 9L Weight 2.58 lbs./ft. Dia. 5 in. to 100 ft. depth Wall Thickness: inches or Dia. <input type="checkbox"/> in. to <input type="checkbox"/> ft. depth gage No. 1279		
			10. Screen: Manufacturer's name PUMPCO MPF Type PVC Dia. 5 <input checked="" type="checkbox"/> gauze .020 Length 40 Set between 80 ft. and 120 ft. ft. and <input type="checkbox"/> ft. Gravel pack? <input checked="" type="checkbox"/> Size range of materials 030/060		
			11. Static water level: <input type="checkbox"/> mo./day/yr. 80 ft. below land surface Date 9-12-78		
			12. Pumping level below land surfaces: <input type="checkbox"/> ft. after <input type="checkbox"/> hrs. pumping <input type="checkbox"/> g.p.m. <input type="checkbox"/> ft. after <input type="checkbox"/> hrs. pumping <input type="checkbox"/> g.p.m. Estimated maximum yield 30 g.p.m.		
			13. Water sample submitted: <input type="checkbox"/> mo./day/yr. <input type="checkbox"/> Yes <input checked="" type="checkbox"/> No Date		
			14. Well head completion: CAP <input type="checkbox"/> Pitless adapter 29 inches above grade		
			15. Well grouted? <input checked="" type="checkbox"/> With: <input checked="" type="checkbox"/> Neat cement <input type="checkbox"/> Bentonite <input type="checkbox"/> Concrete Depth: From 0 ft. to 10 ft.		
			16. Nearest source of possible contamination: ft. 150 Direction NE Type SEPTIC Well disinfected upon completion? <input checked="" type="checkbox"/> Yes <input type="checkbox"/> No		
			17. Pump: <input checked="" type="checkbox"/> Not installed Manufacturer's name _____ Model number _____ HP _____ Volts _____ Length of drop pipe _____ ft. capacity _____ g.p.m. Type: <input type="checkbox"/> Submersible <input type="checkbox"/> Turbine <input type="checkbox"/> Jet <input type="checkbox"/> Reciprocating <input type="checkbox"/> Centrifugal <input type="checkbox"/> Other		
18. Elevation:			20. Water well contractor's certification: This well was drilled under my jurisdiction and this report is true to the best of my knowledge and belief. STRADER DELG CO 182 Business name License No. Address RT 11 HOLLON, KS Signed Dale Askin Date 9-14-78 Authorized representative		
19. Remarks: OWNER TO INSTALL SLAB					

T
R
W
E
S
E
C
1
2
1/4
1/4
1/4
1/4

Forward the white, blue and pink copies to the Department of Health and Environment

Farm WWC-5