


1 LOCATION OF WATER WELL: County: Riley Fraction: Lot 23 Section Number: 2 Township Number: T 10 S Range Number: R 7 EW  
 Distance and direction from nearest town or city street address of well if located within city? 2721 Browning in Manhattan, KS

2 WATER WELL OWNER: Mr. + Mrs. Lyle Timmons  
 RR#, St. Address, Box #: 2721 Browning Av. Board of Agriculture, Division of Water Resources  
 City, State, ZIP Code: Manhattan, Kansas 66502 Application Number:

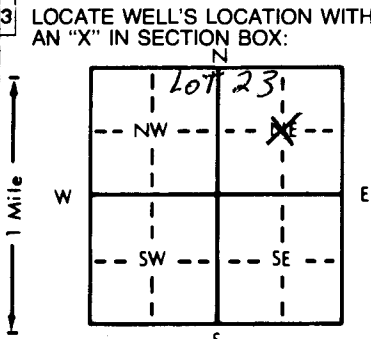

4 DEPTH OF COMPLETED WELL: 106 ft. ELEVATION: .....  
 Depth(s) Groundwater Encountered 1. 94 ft. 2. .... ft. 3. .... ft.  
 WELL'S STATIC WATER LEVEL: 60 ft. below land surface measured on mo/day/yr  
 Pump test data: Well water was ..... ft. after ..... hours pumping ..... gpm  
 Est. Yield: 20 gpm; Well water was ..... ft. after ..... hours pumping ..... gpm  
 Bore Hole Diameter: 8 in. to 10.6 ft., and ..... in. to ..... ft.  
 WELL WATER TO BE USED AS:  
 Domestic  3 Feedlot  6 Oil field water supply  9 Dewatering  12 Other (Specify below)  
 2 Irrigation  4 Industrial  7 Lawn and garden only  10 Monitoring well  
 Was a chemical/bacteriological sample submitted to Department? Yes..... No.....; If yes, mo/day/yr sample was submitted  
 Water Well Disinfected?  Yes  No

5 TYPE OF BLANK CASING USED:  
 1 Steel  3 RMP (SR)  5 Wrought iron  8 Concrete tile  CASING JOINTS:  Glibed  Screwed  Clamped  
 2 PVC  4 ABS  7 Fiberglass  9 Other (specify below)  Welded  
 Blank casing diameter: 5" in. to 9.6 ft., Dia. .... in. to .... ft., Dia. .... in. to .... ft.  
 Casing height above land surface: 2' in., weight Sch 40 lbs./ft. Wall thickness or gauge No. ....  
 TYPE OF SCREEN OR PERFORATION MATERIAL:  
 1 Steel  3 Stainless steel  5 Fiberglass  8 RMP (SR)  10 Asbestos-cement   
 2 Brass  4 Galvanized steel  6 Concrete tile  9 ABS  11 Other (specify) .....  
 12 None used (open hole) .....  
 SCREEN OR PERFORATION OPENINGS ARE:  
 1 Continuous slot  3 Mill slot  16/1000's 5 Gauzed wrapped  8 Saw cut  11 None (open hole)  
 2 Louvered shutter  4 Key punched  7 Torch cut  9 Drilled holes  10 Other (specify) .....  
 SCREEN-PERFORATED INTERVALS: From ..... ft. to ..... ft., From ..... ft. to ..... ft.  
 GRAVEL PACK INTERVALS: From 20 ft. to 106 ft., From ..... ft. to ..... ft.

6 GROUT MATERIAL: 1 Neat cement  2 Cement grout  3 Bentonite  4 Other .....  
 Grout intervals: From 0 ft. to 20 ft., From ..... ft. to Environment ft., From ..... ft. to ..... ft.  
 What is the nearest source of possible contamination:  
 1 Septic tank  4 Lateral lines  7 Pit privy  10 Livestock pens  14 Abandoned water well   
 2 Sewer lines  5 Cess pool  8 Sewage lagoon  11 Fuel storage  15 Oil well/Gas well   
 3 Watertight sewer lines  6 Seepage pit  9 Feedyard  12 Fertilizer storage  16 Other (specify below) .....  
 13 Insecticide storage   
 Direction from well? 120' EAST How many feet? 120'

FROM	TO	LITHOLOGIC LOG	FROM	TO	PLUGGING INTERVALS
0	23	Brown Clay			
23	94	Sandy Clay & Fine Sand			
94	106	Fine Sand & Coarse Sand & Gravel Mixed			

7 CONTRACTOR'S OR LANDOWNER'S CERTIFICATION: This water well was  (1) constructed,  (2) reconstructed, or  (3) plugged under my jurisdiction and was completed on (mo/day/year) 6/28/88 and this record is true to the best of my knowledge and belief. Kansas Water Well Contractor's License No. 451 This Water Well Record was completed on (mo/day/yr) 7/26/88 under the business name of Holdeman Well Drilling by (signature) Ray Hol CWP/PL

OFFICE USE ONLY