

CORRECTION(S) TO WATER WELL RECORD (WWC-5)

(to rectify lacking or incorrect information)

Location listed as:

Section-Township-Range: 5-9-10 S-6-7 E

Fraction ($\frac{1}{4}$ $\frac{1}{4}$ $\frac{1}{4}$): NW SE NW

County: Riley

Location changed to:

5-10 S-7 E

NW SE NW

Other changes: Initial statements: _____

Changed to: _____

Comments: _____


verification method: Well address, area street map, other later well record for same owner at same location, and mapping tool on KGS website. initials: ORL date: 3/12/2007

1 LOCATION OF WATER WELL: County: Riley Fraction: NW 1/4 SE 1/4 NW 1/4 Section Number: 5 Township Number: T 9-10 S Range Number: R 6-70 EW

Distance and direction from nearest town or city street address of well if located within city?
5724 Anderson Ave

2 WATER WELL OWNER: Dean Goff
 RR#, St. Address, Box # : RR Board of Agriculture, Division of Water Resources
 City, State, ZIP Code : Manhattan, Ks. 66502 Application Number:

3 LOCATE WELL'S LOCATION WITH AN "X" IN SECTION BOX:

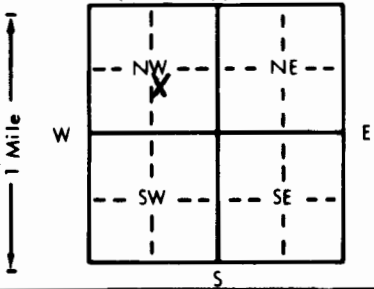

4 DEPTH OF COMPLETED WELL: 90 ft. ELEVATION: ft.
 Depth(s) Groundwater Encountered 1. ft. 2. ft. 3. ft.
 WELL'S STATIC WATER LEVEL 58 ft. below land surface measured on mo/day/yr March 17, 1989
 Pump test data: Well water was ft. after hours pumping gpm
 Est. Yield 15 gpm: Well water was ft. after hours pumping gpm
 Bore Hole Diameter: 8 in. to 90 ft., and in. to ft.
 WELL WATER TO BE USED AS:
 Domestic Feedlot Oil field water supply Dewatering Injection well
 Irrigation Industrial Lawn and garden only Monitoring well
 Was a chemical/bacteriological sample submitted to Department? Yes No ; If yes, mo/day/yr sample was submitted
 Water Well Disinfected? Yes No

5 TYPE OF BLANK CASING USED:
 1 Steel 3 RMP (SR) 5 Wrought iron 8 Concrete tile CASING JOINTS: Glued Clamped
 2 PVC 4 ABS 6 Asbestos-Cement 9 Other (specify below) Welded
 Blank casing diameter in. to 60 ft., Dia in. to ft., Dia in. to ft.
 Casing height above land surface: 18 in., weight 200 lbs./ft. Wall thickness or gauge No.
 TYPE OF SCREEN OR PERFORATION MATERIAL:
 1 Steel 3 Stainless steel 5 Fiberglass 7 PVC 10 Asbestos-cement
 2 Brass 4 Galvanized steel 6 Concrete tile 8 RMP (SR) 11 Other (specify)
 12 None used (open hole)
 SCREEN OR PERFORATION OPENINGS ARE:
 1 Continuous slot 3 Mill slot 5 Gauzed wrapped 8 Saw cut 11 None (open hole)
 2 Louvered shutter 4 Key punched 6 Wire wrapped 9 Drilled holes
 7 Torch cut 10 Other (specify)

SCREEN-PERFORATED INTERVALS: From 60 ft. to 80 ft., From ft. to ft.
 From ft. to ft., From ft. to ft.
 GRAVEL PACK INTERVALS: From 60 ft. to 80 ft., From ft. to ft.
 From ft. to ft., From ft. to ft.

6 GROUT MATERIAL: 1 Neat cement 2 Cement grout 3 Bentonite 4 Other
 Grout Intervals: From 0 ft. to 60 ft., From ft. to ft., From ft. to ft.
 What is the nearest source of possible contamination:
 1 Septic tank 4 Lateral lines 7 Pit privy 10 Livestock pens 14 Abandoned water well
 2 Sewer lines 5 Cess pool 8 Sewage lagoon 11 Fuel storage 15 Oil well/Gas well
 3 Watertight sewer lines 6 Seepage pit 9 Feedyard 12 Fertilizer storage 16 Other (specify below)
 13 Insecticide storage
 Direction from well? North How many feet? 50

FROM	TO	LITHOLOGIC LOG	FROM	TO	PLUGGING INTERVALS
0	20	Brown Clay			
20	27	Creek Gravel			
27	30	Red Shale			
30	32	Tan Shale			
32	33	Limestone			
33	41	Gray Shale			
41	45	Red Shale			
45	49	Limestone			
49	67	Gray Shale			
67	69	Limestone			
69	90	Gray Shale			

7 CONTRACTOR'S OR LANDOWNER'S CERTIFICATION: This water well was constructed, reconstructed, or plugged under my jurisdiction and was completed on (mo/day/year) March 17, 1989 and this record is true to the best of my knowledge and belief. Kansas Water Well Contractor's License No. 234 This Water Well Record was completed on (mo/day/yr) March 17, 1989 under the business name of Blue Valley Drilling by (signature) Betty Galtrader