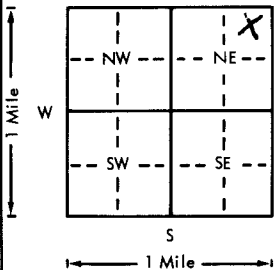
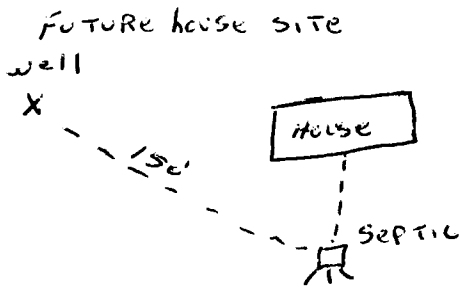


USE TYPEWRITER OR BALL
POINT PEN-PRESS FIRMLY,
PRINT CLEARLY.

WATER WELL RECORD
KSA 82a-1201-1215

Kansas Department of Health and
Environment-Division of Environment
(Water well Contractors)
Topeka, Kansas 66620

LOT # 30

1. Location of well:		County Riley	Fraction NE 1/4 NE 1/4 NE 1/4	Section number 10	Township number T 10 S 7 E	Range number 7 E
2. Distance and direction from nearest town or city: 5 W OF			3. Owner of well: LITTLE KITTEN CR. INC.			
Street address of well location if in city: MANHATTAN			R.R. or street: 1919 Indiana			
			City, state, zip code: MANHATTAN, KS			
4. Locate with "X" in section below:		Sketch map:		6. Bore hole dia. 10 in. Completion date 5-2-78		
				Well depth 100 ft.		
5. Type and color of material		From	To	7. <input type="checkbox"/> Cable tool <input checked="" type="checkbox"/> Rotary <input type="checkbox"/> Driven <input type="checkbox"/> Dug		
TOP SOIL		0	3	<input type="checkbox"/> Hollow rod <input type="checkbox"/> Jetted <input type="checkbox"/> Bored <input type="checkbox"/> Reverse rotary		
Clay, BROWN		3	23	8. Use: <input checked="" type="checkbox"/> Domestic <input type="checkbox"/> Public supply <input type="checkbox"/> Industry		
CHERT, GRAVEL		23	27	<input type="checkbox"/> Irrigation <input type="checkbox"/> Air conditioning <input type="checkbox"/> Stock		
Clay, BROWN		27	29	<input type="checkbox"/> Lawn <input type="checkbox"/> Oil field water <input type="checkbox"/> Other		
Shale, grey		29	36	9. Casing: Material PVC Height: Above or below		
Limestone, BROWN		36	37	Threaded <input type="checkbox"/> Welded <input type="checkbox"/> Surface 24 in.		
Shale, grey, Limestone, grey		37	84	RMP <input type="checkbox"/> PVC 94 Weight 2.58 lbs./ft.		
Shale, Lime, grey, B.K. grey		84	86	Dia. 5 in. to 100 ft. depth Wall Thickness: inches or		
Shale, grey, Limestone grey		86	100	Dia. <input type="checkbox"/> in. to <input type="checkbox"/> ft. depth Gage No. 1274		
				10. Screen: Manufacturer's name PUMPCO MPI		
				Type PVC Dia. 5		
				Slot gauge 0.060 Length 40		
				Set between 20 ft. and 90 ft.		
				90 ft. and 100 ft.		
				Gravel pack? <input checked="" type="checkbox"/> Size range of material 1/4 x 1/8		
				11. Static water level: <input type="checkbox"/> mo./day/yr.		
				15 ft. below land surface Date 5-2-78		
				12. Pumping level below land surfaces:		
				<input type="checkbox"/> ft. after <input type="checkbox"/> hrs. pumping <input type="checkbox"/> g.p.m.		
				<input type="checkbox"/> ft. after <input type="checkbox"/> hrs. pumping <input type="checkbox"/> g.p.m.		
				Estimated maximum yield 50 g.p.m.		
				13. Water sample submitted: <input type="checkbox"/> mo./day/yr.		
				Yes <input checked="" type="checkbox"/> No <input type="checkbox"/> Date <input type="checkbox"/>		
				14. Well head completion:		
				<input type="checkbox"/> Pitless adapter 24 Inches above grade		
				15. Well grouted? <input checked="" type="checkbox"/>		
				With: <input checked="" type="checkbox"/> Neat cement <input type="checkbox"/> Bentonite <input type="checkbox"/> Concrete		
				Depth: From 0 ft. to 19 ft.		
				16. Nearest source of possible contamination:		
				ft. 150 Direction SE Type SEPTIC		
				Well disinfected upon completion? <input checked="" type="checkbox"/> Yes <input type="checkbox"/> No		
				17. Pump: <input checked="" type="checkbox"/> Not installed		
				Manufacturer's name <input type="checkbox"/>		
				Model number <input type="checkbox"/> HP <input type="checkbox"/> Volts <input type="checkbox"/>		
				Length of drop pipe <input type="checkbox"/> ft. capacity <input type="checkbox"/> g.p.m.		
				Type:		
				<input type="checkbox"/> Submersible <input type="checkbox"/> Turbine		
				<input type="checkbox"/> Jet <input type="checkbox"/> Reciprocating		
				<input type="checkbox"/> Centrifugal <input type="checkbox"/> Other		
18. Elevation:		19. Remarks:		20. Water well contractor's certification:		
Topography:		OWNER TO INSTALL SLAB		This well was drilled under my jurisdiction and this report is true to the best of my knowledge and belief.		
<input type="checkbox"/> Hill				STRADER DAIG. CO INC 182		
<input checked="" type="checkbox"/> Slope				Business name <input type="checkbox"/> License No. <input type="checkbox"/>		
<input type="checkbox"/> Upland				Address RT 1 HOLTON, KS		
<input type="checkbox"/> Valley				Signed Dale Osburn Date 5-4-78		
				Authorized representative		

Forward the white, blue and pink copies to the Department of Health and Environment

Form WWC-5