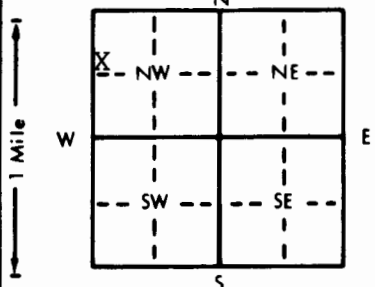


1 LOCATION OF WATER WELL: Fraction Section Number Township Number Range Number
 County: RILEY SW 1/4 NW 1/4 NW 1/4 10 T 10 S R 7 EW

Distance and direction from nearest town or city street address of well if located within city?
 1/2 west of Manhattan

2 WATER WELL OWNER: Gill S. Bikram Sharing Brook Add. Lot #29
 RR#, St. Address, Box #: 3905 Erin Circle Ray's job Board of Agriculture, Division of Water Resources
 City, State, ZIP Code: Manhattan, KS 66502 Application Number:

3 LOCATE WELL'S LOCATION WITH AN "X" IN SECTION BOX:  4 DEPTH OF COMPLETED WELL: 120' ft. ELEVATION:
 Depth(s) Groundwater Encountered 1. ~~88~~ 88-92 ft. 2. ft. 3. ft.
 WELL'S STATIC WATER LEVEL: 62' ft. below land surface measured on mo/day/yr 5-07-92
 Pump test data: Well water was ft. after hours pumping gpm
 Est. Yield: 40 gpm: Well water was ft. after hours pumping gpm
 Bore Hole Diameter: 8 3/4 in. to ft., and in. to ft.
 WELL WATER TO BE USED AS: 5 Public water supply 8 Air conditioning 11 Injection well
 1 Domestic 3 Feedlot 6 Oil field water supply 9 Dewatering 12 Other (Specify below)
 2 Irrigation 4 Industrial 7 Lawn and garden only 10 Monitoring well
 Was a chemical/bacteriological sample submitted to Department? Yes No X; If yes, mo/day/yr sample was submitted
 Water Well Disinfected? Yes X No

5 TYPE OF BLANK CASING USED: 5 Wrought iron 8 Concrete tile CASING JOINTS: Glued X Clamped
 1 Steel 3 RMP (SR) 6 Asbestos-Cement 9 Other (specify below) Welded
 2 PVC 4 ABS 7 Fiberglass Threaded
 Blank casing diameter 5" in. to 0-80 ft., Dia. in. to ft., Dia. in. to ft.
 Casing height above land surface 24" in., weight 2.82 lbs./ft. Wall thickness or gauge No. 258
 TYPE OF SCREEN OR PERFORATION MATERIAL: 7 PVC 10 Asbestos-cement
 1 Steel 3 Stainless steel 5 Fiberglass 8 RMP (SR) 11 Other (specify)
 2 Brass 4 Galvanized steel 6 Concrete tile 9 ABS 12 None used (open hole)
 SCREEN OR PERFORATION OPENINGS ARE: 5 Gauzed wrapped 8 Saw cut 11 None (open hole)
 1 Continuous slot 3 Mill slot 6 Wire wrapped 9 Drilled holes
 2 Louvered shutter 4 Key punched 7 Torch cut 10 Other (specify)
 SCREEN-PERFORATED INTERVALS: From 80 ft. to 120 ft., From ft. to ft.
 From ft. to ft., From ft. to ft.
 GRAVEL PACK INTERVALS: From 24 ft. to 120 ft., From ft. to ft.
 From ft. to ft., From ft. to ft.

6 GROUT MATERIAL: 1 Neat cement 2 Cement grout 3 Bentonite 4 Other
 Grout intervals: From 4 ft. to 24 ft., From ft. to ft., From ft. to ft.
 What is the nearest source of possible contamination:
 1 Septic tank 4 Lateral lines 7 Pit privy 10 Livestock pens 14 Abandoned water well
 2 Sewer lines 5 Cess pool 8 Sewage lagoon 11 Fuel storage 15 Oil well/Gas well
 3 Watertight sewer lines 6 Seepage pit 9 Feedyard 12 Fertilizer storage 16 Other (specify below)
 13 Insecticide storage
 Direction from well? west How many feet? 100'

FROM	TO	LITHOLOGIC LOG	FROM	TO	PLUGGING INTERVALS
0	7	Clay-Brown	60	70	Shale-Grey
7	21	Silty Clay-Brown	70	75	Limestone-Grey
21	26	Chert 1/2-1/2 loose caving	75	79	Shale-Black
26	28	Limestone-Grey	79	88	Limestone-Grey
28	29	Shale-Black	88	92	Limestone-Grey-loose 40 GPM
29	31	Limestone-Grey	92	120	Shaley Limestone-Grey
31	39	Shale-Yellow			
39	42	Limestone-Grey			
42	43	Shale-Grey			
43	46	Limestone-Grey			
46	50	Shale-Grey			
50	52	Limestone-Grey			
52	59	Shale-Grey			
59	60	Shale-Red			

7 CONTRACTOR'S OR LANDOWNER'S CERTIFICATION: This water well was (1) constructed, (2) reconstructed, or (3) plugged under my jurisdiction and was completed on (mo/day/year) 5-07-92 and this record is true to the best of my knowledge and belief. Kansas Water Well Contractor's License No. 182. This Water Well Record was completed on (mo/day/yr) 6-7-92 under the business name of STRADER DRILLING CO., INC. by (signature) Dale Bikram

OFFICE USE ONLY T R EW SEC 1/4 1/4 1/4