


1 LOCATION OF WATER WELL: County: Riley Fraction: Center SW SW 1/4 NE 1/4 Section Number: 10 Township Number: T 10 S Range Number: R 7 E/W
 Distance and direction from nearest town or city street address of well if located within city? 1700 GRYSTONE IN CITY

2 WATER WELL OWNER: Don Shriner RR#, St. Address, Box #: Greystone Board of Agriculture, Division of Water Resources
 City, State, ZIP Code: Marhattan, KS 66502 Application Number:

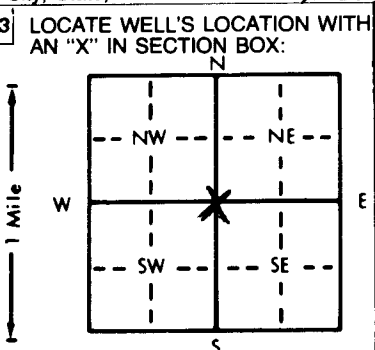

4 DEPTH OF COMPLETED WELL: 120 ft. ELEVATION:ft.
 Depth(s) Groundwater Encountered 1. 87 ft. 2.ft. 3.ft.
 WELL'S STATIC WATER LEVEL: 80 ft. below land surface measured on mo/day/yr
 Pump test data: Well water wasft. after hours pumping gpm
 Est. Yield: 50 gpm; Well water wasft. after hours pumping gpm
 Bore Hole Diameter: 9 in. to 120 ft., and in. to ft.
 WELL WATER TO BE USED AS:
 5 Public water supply 8 Air conditioning 11 Injection well
 1 Domestic 3 Feedlot 6 Oil field water supply 9 Dewatering 12 Other (Specify below)
 2 Irrigation 4 Industrial 7 Lawn and garden only 10 Monitoring well
 Was a chemical/bacteriological sample submitted to Department? Yes.....No.....; If yes, mo/day/yr sample was submitted
 Water Well Disinfected? Yes No

5 TYPE OF BLANK CASING USED:
 1 Steel 3 RMP (SR) 5 Wrought iron 8 Concrete tile CASING JOINTS: Glued Clamped
2 PVC 4 ABS 6 Asbestos-Cement 9 Other (specify below) Welded
 7 Fiberglass Threaded
 Blank casing diameter: 5 in. to 100 ft. Dia. in. to ft. Dia. in. to ft.
 Casing height above land surface: 2 in., weight 5640 lbs./ft. Wall thickness or gauge No.
 TYPE OF SCREEN OR PERFORATION MATERIAL:
 1 Steel 3 Stainless steel 5 Fiberglass 7 PVC 10 Asbestos-cement
 2 Brass 4 Galvanized steel 6 Concrete tile 8 RMP (SR) 11 Other (specify)
 9 ABS 12 None used (open hole)
 SCREEN OR PERFORATION OPENINGS ARE: 25 1000
 1 Continuous slot 3 Mill slot 5 Gauzed wrapped 8 Saw cut 11 None (open hole)
 2 Louvered shutter 4 Key punched 6 Wire wrapped 9 Drilled holes
 7 Torch cut 10 Other (specify)
 SCREEN-PERFORATED INTERVALS: From 100 ft. to 120 ft. From ft. to ft.
 From ft. to ft. From ft. to ft.
 GRAVEL PACK INTERVALS: From 25 ft. to 120 ft. From ft. to ft.
 From ft. to ft. From ft. to ft.

6 GROUT MATERIAL: 1 Neat cement 2 Cement grout 3 Bentonite 4 Other
 Grout Intervals: From 0 ft. to 25 ft. From ft. to ft. From ft. to ft.
 What is the nearest source of possible contamination: None Close
 1 Septic tank 4 Lateral lines 7 Pit privy 10 Livestock pens 14 Abandoned water well
 2 Sewer lines 5 Cess pool 8 Sewage lagoon 11 Fuel storage 15 Oil well/Gas well
 3 Watertight sewer lines 6 Seepage pit 9 Feedyard 12 Fertilizer storage 16 Other (specify below)
 13 Insecticide storage
 Direction from well? How many feet?

FROM	TO	LITHOLOGIC LOG	FROM	TO	PLUGGING INTERVALS
0	2	Top Soil			
2	39	Brown Clay			
39	44	Gravel			
44	45	Limestone			
45	61	Grey shale			
61	66	Limestone			
66	89	Brown shale			
89	93	Limestone (water)			
93	106	Brown shale			
106	108	Limestone			
108	120	Grey shale			

7 CONTRACTOR'S OR LANDOWNER'S CERTIFICATION: This water well was (1) constructed, (2) reconstructed, or (3) plugged under my jurisdiction and was completed on (mo/day/year) 9/18/92 and this record is true to the best of my knowledge and belief. Kansas Water Well Contractor's License No. 451 This Water Well Record was completed on (mo/day/yr) 10/12/92 under the business name of Haldeman Well Drilling by (signature) Clayton CWD/PI

OFFICE USE ONLY T R E/W SEC. 1/4 1/4 1/4