


1 LOCATION OF WATER WELL: County: Riley Fraction NW 1/4 NW 1/4 NW 1/4 Section Number 14 Township Number T 10 S Range Number R 7 E Distance and direction from nearest town or city street address of well if located within city? 700 FAIRMONT

2 WATER WELL OWNER: Russel Weisbender RR#, St. Address, Box #: 700 FAIRMONT City, State, ZIP Code: Manhattan, Kansas 66502 Board of Agriculture, Division of Water Resources Application Number:

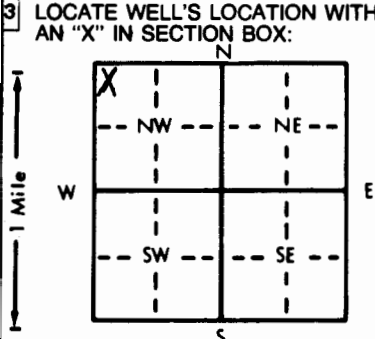

3 LOCATE WELL'S LOCATION WITH AN 'X' IN SECTION BOX: 4 DEPTH OF COMPLETED WELL: 60 ft. ELEVATION: WELL'S STATIC WATER LEVEL: 1.5 ft. below land surface measured on mo/day/yr. Includes lists for well water use (Domestic, Irrigation, etc.) and casing joints.

5 TYPE OF BLANK CASING USED: 1 Steel, 2 PVC, 3 RMP (SR), 4 ABS, 5 Wrought iron, 6 Asbestos-Cement, 7 Fiberglass, 8 Concrete tile, 9 Other, 10 Asbestos-cement, 11 Other, 12 None used. Includes screen/perforation material and intervals.

6 GROUT MATERIAL: 1 Neat cement, 2 Cement grout, 3 Bentonite. Includes grout intervals and nearest source of possible contamination.

LITHOLOGIC LOG and PLUGGING INTERVALS table with columns for FROM, TO, LITHOLOGIC LOG, FROM, TO, PLUGGING INTERVALS. Includes handwritten entries for soil, clay, gravel, shale, and limestone.

7 CONTRACTOR'S OR LANDOWNER'S CERTIFICATION: This water well was (1) constructed (2) reconstructed, or (3) plugged under my jurisdiction and was completed on 7/25/89. This Water Well Record was completed on 8/29/89 under the business name of Haldeman well Drilling.

OFFICE USE ONLY T R E M SEC. 1/4 1/4