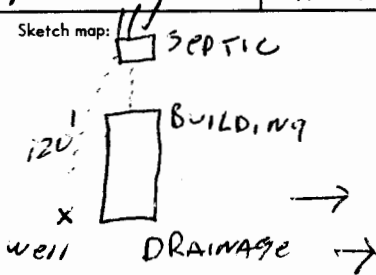


USE TYPEWRITER OR BALL POINT PEN-PRESS FIRMLY, PRINT CLEARLY.

WATER WELL RECORD
KSA 82a-1201-1215

Kansas Department of Health and Environment-Division of Environment
(Water well Contractors)
Topeka, Kansas 66620

1. Location of well:	County Riley	Fraction SE 1/4 SE 1/4 SE 1/4	Section number 28	Township number T 10 S R 7 EW	Range number
2. Distance and direction from nearest town or city: 2 mi E Street address of well location if in city: OF Odgen			3. Owner of well: ERIN FRANKLIN R.R. or street: City, state, zip code: MANHATTAN, KS		
4. Locate with "X" in section below: N W E S 1 Mile		Sketch map: 		6. Bore hole dia. 10 in. Completion date _____ Well depth 50 ft. 5-3-76	
5. Type and color of material		From	To	7. Cable tool <input checked="" type="checkbox"/> Rotary <input type="checkbox"/> Driven <input type="checkbox"/> Dug <input type="checkbox"/> Hollow rod <input type="checkbox"/> Jetted <input type="checkbox"/> Bored <input type="checkbox"/> Reverse rotary	
				8. Use: <input checked="" type="checkbox"/> Domestic <input type="checkbox"/> Public supply <input checked="" type="checkbox"/> Industry <input type="checkbox"/> Irrigation <input type="checkbox"/> Air conditioning <input type="checkbox"/> Stock <input type="checkbox"/> Lawn <input type="checkbox"/> Oil field water <input type="checkbox"/> Other	
				9. Casing: Material PVC Height: Above or below Threaded <input type="checkbox"/> Welded <input type="checkbox"/> Surface 24 in. RMP <input type="checkbox"/> PVC 9L Weight 2.38 lbs./ft. Dia. 5 in. to 50 ft. depth Wall Thickness: inches or Dia. _____ in. to _____ ft. depth gage No. 1258	
				10. Screen: Manufacturer's name Rumpeco Type PVC Dia. 5 Slot/gauze .060 Length 5 Set between 45 ft. and 50 ft. ft. and _____ ft. Gravel pack? <input checked="" type="checkbox"/> Size range of material 1/4" #18	
				11. Static water level: _____ mo./day/yr. 22 ft. below land surface Date 5-3-76	
				12. Pumping level below land surfaces: AIR TEST _____ ft. after _____ hrs. pumping _____ g.p.m. _____ ft. after _____ hrs. pumping _____ g.p.m. Estimated maximum yield 50 g.p.m.	
				13. Water sample submitted: _____ mo./day/yr. Yes <input type="checkbox"/> No <input checked="" type="checkbox"/> Date _____	
				14. Well head completion: CAPPED <input type="checkbox"/> Pitless adapter 24 Inches above grade	
				15. Well grouted? <input checked="" type="checkbox"/> With: <input checked="" type="checkbox"/> Neat cement <input type="checkbox"/> Bentonite <input type="checkbox"/> Concrete Depth: From 0 ft. to 10 ft.	
				16. Nearest source of possible contamination: _____ ft. 120 Direction N Type SEPTIC Well disinfected upon completion? <input checked="" type="checkbox"/> Yes <input type="checkbox"/> No	
				17. Pump: <input checked="" type="checkbox"/> Not installed Manufacturer's name _____ Model number _____ HP _____ Volts _____ Length of drop pipe _____ ft. capacity _____ g.p.m. Type: <input type="checkbox"/> Submersible <input type="checkbox"/> Turbine <input type="checkbox"/> Jet <input type="checkbox"/> Reciprocating <input type="checkbox"/> Centrifugal <input type="checkbox"/> Other	
		(Use a second sheet if needed)			
18. Elevation: Topography: <input type="checkbox"/> Hill <input type="checkbox"/> Slope <input type="checkbox"/> Upland <input checked="" type="checkbox"/> Valley	19. Remarks: OWNER WILL INSTALL SLAB			20. Water well contractor's certification: This well was drilled under my jurisdiction and this report is true to the best of my knowledge and belief. Steady Dalg Co Inc 182 Business name License No. Address RT1 Manhattan, KS Signed Dale Robinson Date 5-8-76 Authorized representative	

T 10
R 7
W E
Sec 28
1/4 S E S E S E
1/4

Forward the white, blue and pink copies to the Department of Health and Environment

Form WWC-5