

USE TYPEWRITER OR BALL POINT PEN-PRESS FIRMLY, PRINT CLEARLY.


Well no 2

Su^{ty}
NE¹/₄ SE¹/₄ NE¹/₄ 28

WATER WELL RECORD
KSA 82a-1201-1215

Kansas Department of Health and
Environment-Division of Environment
(Water well Contractors)
Topeka, Kansas 66620

1. Location of well: County Riley Fraction NE¹/₄ SE¹/₄ NE¹/₄ Section number 16 Township number 10 south Range number R.7. east
 2. Distance and direction from nearest town or city: 1 West Manhattan, Mo. 3. Name of well: Lester City Cr
 Street address of well location if in city: south of odd Fellows lodge R.R. or street: RFD 1
 City, state, zip code: Manhattan KS. 66502

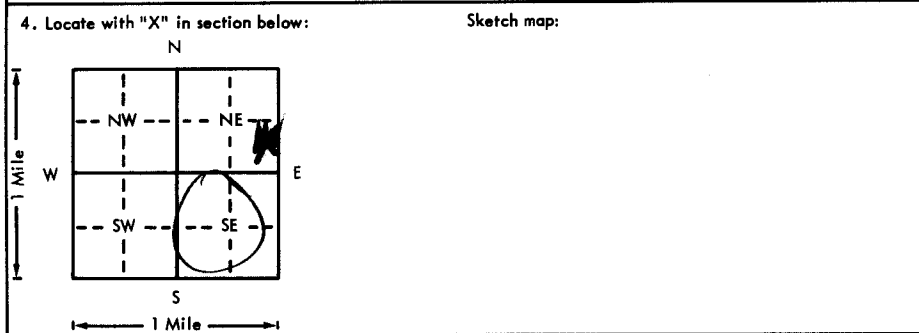

6. Bore hole dia. 4 in. Completion date 5-5-77
 Well depth 76 ft.
 7. Cable tool Rotary Driven Dug
 Hollow rod Jetted Bored Reverse rotary
 8. Use: Domestic Public supply Industry
 Irrigation Air conditioning Stock
 Lawn Oil field water Other
 9. Casing: Material steel Height: Above or below
 Threaded Welded Surface 12 in.
 RMP PVC Weight 24 lbs./ft.
 Dia. 4 1/2 in. to 76 ft. depth; Wall Thickness: 3/32 inches or
 Dia. 4 1/2 in. to 76 ft. depth; gage No. 273 mly 5

5. Type and color of material	From	To
top soil	0	14
Loam sandy	14	29
Sand quick clay	29	30
sand + gravel	30	70
gravel	70	76
(Use a second sheet if needed)		

10. Screen: Manufacturer's name Perforated
 Type steel Dia. 6 1/2 I.D.
 Slot/gauze .060 Length 42 ft.
 Set between 72 ft. and 76 ft.
 Gravel pack? Size range of material 8X #4
 11. Static water level: 35 ft. below land surface Date 5-5-77
 12. Pumping level below land surfaces:
 ft. after hrs. pumping g.p.m.
 ft. after hrs. pumping g.p.m.
 Estimated maximum yield 40 g.p.m.
 13. Water sample submitted: mo./day/yr.
 Yes No Date
 14. Well head completion:
 Pitless adapter inches above grade
 15. Well grouted?
 With: Neat cement Bentonite Concrete
 Depth: From 15 ft. to 5 ft.
 16. Nearest source of possible contamination:
 ft. 120 Direction West Type Septic tank
 Well disinfected upon completion? Yes No
 17. Pump: Not installed
 Manufacturer's name
 Model number HP Volts
 Length of drop pipe ft. capacity g.p.m.
 Type:
 Submersible Turbine
 Jet Reciprocating
 Centrifugal Other

18. Elevation: 1037
 Topography:
 Hill
 Slope
 Upland
 Valley

19. Remarks:

20. Water well contractor's certification:
 This well was drilled under my jurisdiction and this report is true to the best of my knowledge and belief.
 H. Strader Drilling Co. #37
 Business name Blue Refills License No.
 Address
 Signed Harold Strader Date 5-5-77
 Authorized representative

1-20-77
 Sec 16
 NE 1/4
 SE 1/4