


lot no 18 south of Daniel ave

1 LOCATION OF WATER WELL: Fraction NE 1/4 SW 1/4 Section Number 28 Township Number T 10 S Range Number R 7 E
 County: Riley

Distance and direction from nearest town or city street address of well if located within city?
Manhattan S. Weston 18 Highway 2 miles to road on right + West 1 mi to Adly addition + left on south
 2 WATER WELL OWNER: Larry Jensen
 RR#, St. Address, Box #, City, State, ZIP Code: 147 Daniel Ave. Manhattan Kansas 66502
 Board of Agriculture, Division of Water Resources Application Number:

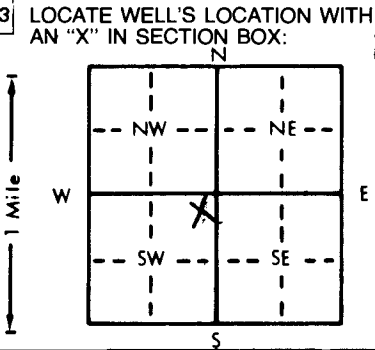

4 DEPTH OF COMPLETED WELL: 90 ft. ELEVATION:
 Depth(s) Groundwater Encountered 1. 65 ft. 2. _____ ft. 3. _____ ft.
 WELL'S STATIC WATER LEVEL: 4.0 ft. below land surface measured on mo/day/yr Jan 21-83
 Pump test data: Well water was _____ ft. after _____ hours pumping _____ gpm
 Est. Yield 35 gpm: Well water was _____ ft. after _____ hours pumping _____ gpm
 Bore Hole Diameter: 1.4 in. to 1.6 in. and 7 in. to 7.0 in.
 WELL WATER TO BE USED AS:
 1 Domestic 3 Feedlot 6 Oil field water supply 9 Dewatering 12 Other (Specify below)
 2 Irrigation 4 Industrial 7 Lawn and garden only 10 Observation well
 Was a chemical/bacteriological sample submitted to Department? Yes _____ No If yes, mo/day/yr sample was submitted _____
 Water Well Disinfected? Yes No _____

5 TYPE OF BLANK CASING USED:
 1 Steel 3 RMP (SR) 6 Asbestos-Cement 9 Other (specify below)
 2 PVC 4 ABS 7 Fiberglass
 Blank casing diameter: 7 in. to Bottom ft. Dia _____ in. to _____ ft. Dia _____ in. to _____ ft.
 Casing height above land surface: 12 in., weight _____ lbs./ft. Wall thickness or gauge No. 23.2 Wall
 TYPE OF SCREEN OR PERFORATION MATERIAL:
 1 Steel 3 Stainless steel 5 Fiberglass 8 RMP (SR) 11 Other (specify) _____
 2 Brass 4 Galvanized steel 6 Concrete tile 9 ABS 12 None used (open hole)
 SCREEN OR PERFORATION OPENINGS ARE:
 1 Continuous slot 3 Mill slot 5 Gauzed wrapped 8 Saw cut 11 None (open hole)
 2 Louvered shutter 4 Key punched 7 Torch cut 9 Drilled holes 10 Other (specify) _____
 SCREEN-PERFORATED INTERVALS: From 65 ft. to 70 ft. From _____ ft. to _____ ft.
 GRAVEL PACK INTERVALS: From none ft. to _____ ft. From _____ ft. to _____ ft.

6 GROUT MATERIAL: 1 Neat cement 2 Cement grout 3 Bentonite 4 Other _____
 Grout Intervals: From 1.6 ft. to 5 ft. From _____ ft. to _____ ft. From _____ ft. to _____ ft.
 What is the nearest source of possible contamination:
 1 Septic tank 4 Lateral lines 7 Pit privy 10 Livestock pens 14 Abandoned water well
 2 Sewer lines 5 Cess pool 8 Sewage lagoon 11 Fuel storage 15 Oil well/Gas well
 3 Watertight sewer lines 6 Seepage pit 9 Feedyard 12 Fertilizer storage 16 Other (specify below) _____
 13 Insecticide storage
 Direction from well? South How many feet? 10.0

FROM	TO	LITHOLOGIC LOG	FROM	TO	LITHOLOGIC LOG
0	20	Clay, Brown			
20	38	Sand, Blue Fine			
38	60	sand, Sand + Gravel			
60	69	gravel, Shale at 69'			
69	70	Shale, Blue			

7 CONTRACTOR'S OR LANDOWNER'S CERTIFICATION: This water well was (1) constructed, (2) reconstructed, or (3) plugged under my jurisdiction and was completed on (mo/day/year) 1-21-83 and this record is true to the best of my knowledge and belief. Kansas Water Well Contractor's License No. 237 This Water Well Record was completed on (mo/day/yr) 1-22-83 under the business name of Strader Drilling Co by (signature) Harold Strader

INSTRUCTIONS: Use typewriter or ball point pen, PLEASE PRESS FIRMLY and PRINT clearly. Please fill in blanks, underline or circle the correct answers. Send top three copies to Kansas Department of Health and Environment, Division of Environment, Environmental Geology Section, Topeka, KS 66620. Send one to WATER WELL OWNER and retain one for your records.

DP

OFFICE USE ONLY

T

10

R

2

EW

SEC.

20

NE 1/4

NE 1/4

SW 1/4