

37

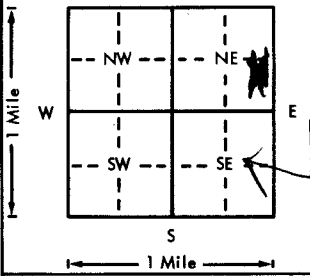
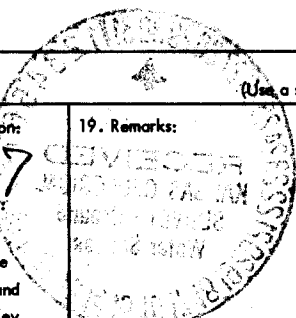
Well no 1

USE TYPEWRITER OR BALL POINT PEN-PRESS FIRMLY, PRINT CLEARLY.

SW 1/4 NE 1/4 SE 1/4 NE 1/4 28

WATER WELL RECORD
KSA 82a-1201-1215

Kansas Department of Health and Environment-Division of Environment
(Water well Contractors)
Topeka, Kansas 66620

1. Location of well: County Riley		Fraction Northwest 1/4		Section number 16		Township number 10 South		Range number R 7 East	
2. Distance and direction from nearest town or city: 1 West Manhattan on 18 Highway + West to odd Fallows Lodge then South side				3. Owner of well: Leisterady Sr.					
4. Locate with "X" in section below: Sketch map: 				6. Bore hole dia. 1 1/2 in. Completion date 5-3-77 Well depth 78 ft.					
				7. <input checked="" type="checkbox"/> Cable tool <input type="checkbox"/> Rotary <input type="checkbox"/> Driven <input type="checkbox"/> Dug <input type="checkbox"/> Hollow rod <input type="checkbox"/> Jetted <input type="checkbox"/> Bored <input type="checkbox"/> Reverse rotary					
				8. Use: <input checked="" type="checkbox"/> Domestic <input type="checkbox"/> Public supply <input type="checkbox"/> Industry <input type="checkbox"/> Irrigation <input type="checkbox"/> Air conditioning <input type="checkbox"/> Stock <input type="checkbox"/> Lawn <input type="checkbox"/> Oil field water <input type="checkbox"/> Other					
				9. Casing: Material STEEL Height: Above or below Threaded <input checked="" type="checkbox"/> Welded <input type="checkbox"/> Surface 1 1/4 in. RMP <input type="checkbox"/> PVC <input type="checkbox"/> Weight 24 lbs./ft. Dia. 1 1/2 in. to 78 ft. depth Wall Thickness: inches or Dia. <input type="checkbox"/> in. to <input type="checkbox"/> ft. depth Gage No. 272 MKC					
5. Type and color of material				From		To			
top Soil				0		15			
Sandy loam				15		30			
Sand, light gray				30		49			
Chalk Sand + gravel yellow				49		75			
Chalk Blue				75		78			
				10. Screens: Manufacturer's name Perforated Type Steel Dia. 6 1/2 Slot/gauze 0.60 Length 4 ft Set between 71 ft. and 75 ft. Gravel pack? <input checked="" type="checkbox"/> Size range of material 4-10					
				11. Static water level: 35 ft. below land surface Date May 3-77					
				12. Pumping level below land surfaces: ____ ft. after ____ hrs. pumping ____ g.p.m. ____ ft. after ____ hrs. pumping ____ g.p.m. Estimated maximum yield 40 g.p.m.					
				13. Water sample submitted: <input checked="" type="checkbox"/> Yes <input type="checkbox"/> No Date NA					
				14. Well head completion: NA <input type="checkbox"/> Pitless adapter ____ inches above grade					
				15. Well grouted? <input checked="" type="checkbox"/> With: <input checked="" type="checkbox"/> Neat cement <input type="checkbox"/> Bentonite <input checked="" type="checkbox"/> Concrete Depth: From 15 ft. to 5 ft.					
				16. Nearest source of possible contamination: 100 ft. Direction West Type Septic tank Well disinfected upon completion? <input checked="" type="checkbox"/> Yes <input type="checkbox"/> No					
				17. Pump: <input checked="" type="checkbox"/> Not installed Manufacturer's name _____ Model number _____ HP _____ Valvs _____ Length of drop pipe _____ ft. capacity _____ g.p.m. Type: <input type="checkbox"/> Submersible <input type="checkbox"/> Turbine <input type="checkbox"/> Jet <input type="checkbox"/> Reciprocating <input type="checkbox"/> Centrifugal <input type="checkbox"/> Other					
18. Elevation: 1037		19. Remarks:							
Topographic: <input type="checkbox"/> Hill <input type="checkbox"/> Slope <input type="checkbox"/> Upland <input checked="" type="checkbox"/> Valley									
				20. Water well contractor's certification: This well was drilled under my jurisdiction and this report is true to the best of my knowledge and belief. S. Trader Drilling Co 23 Business name Blue Republic License No. _____ Address _____ Signed Harold Stader Date 5-3-77 Authorized representative					

Forward the white, blue and pink copies to the Department of Health and Environment

Form WWC-5