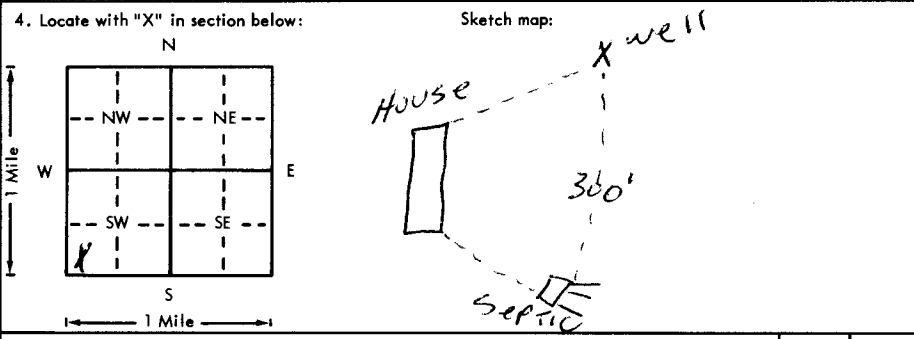


USE TYPEWRITER OR BALL POINT PEN—PRESS FIRMLY, PRINT CLEARLY.

WATER WELL RECORD  
KSA 82a-1201-1215

Kansas Department of Health and Environment—Division of Environment  
(Water well Contractors)  
Topeka, Kansas 66620

1. Location of well:	County <b>Riley</b>	Fraction <b>SW 1/4 SW 1/4 SW 1/4</b>	Section number <b>27</b>	Township number <b>T 10 S R 7 E/W</b>	Range number
2. Distance and direction from nearest town or city: <b>3 SW</b> Street address of well location if in city: <b>OF MANHATTAN</b>			3. Owner of well: <b>BART THOMAS</b> R.R. or street: <b>RT 1</b> City, state, zip code: <b>MANHATTAN KS 66502</b>		
4. Locate with "X" in section below: 			6. Bore hole dia. <b>8</b> in. Completion date <b>9-16-76</b> Well depth <b>200</b> ft.		
5. Type and color of material			7. Cable tool <input checked="" type="checkbox"/> Rotary <input type="checkbox"/> Driven <input type="checkbox"/> Dug <input type="checkbox"/> Hollow rod <input type="checkbox"/> Jetted <input type="checkbox"/> Bored <input type="checkbox"/> Reverse rotary		
			8. Use: <input checked="" type="checkbox"/> Domestic <input type="checkbox"/> Public supply <input type="checkbox"/> Industry <input type="checkbox"/> Irrigation <input type="checkbox"/> Air conditioning <input type="checkbox"/> Stock <input type="checkbox"/> Lawn <input type="checkbox"/> Oil field water <input type="checkbox"/> Other		
			9. Casing: Material <b>PVC</b> Height: <b>Above</b> or below Threaded <input type="checkbox"/> Welded <input type="checkbox"/> Surface <b>28</b> in. RMP <input type="checkbox"/> PVC <b>92</b> Weight <b>2.58</b> lbs./ft. Dia. <b>5</b> in. to <b>200</b> ft. depth Wall Thickness: inches or Dia. <input type="checkbox"/> in. to <input type="checkbox"/> ft. depth gage No. <b>2.74</b>		
			10. Screen: Manufacturer's name <b>PUMPCO</b> Type <b>PVC</b> Dia. <b>5</b> Sig/gauze <b>0.60</b> Length <b>40</b> Set between <b>160</b> ft. and <b>200</b> ft. Gravel pack? <input checked="" type="checkbox"/> Size range of material <b>1/4-1/8</b>		
			11. Static water level: <input type="checkbox"/> mo./day/yr. <b>172</b> ft. below land surface Date <b>9-16-76</b>		
			12. Pumping level below land surfaces: ____ ft. after ____ hrs. pumping ____ g.p.m. ____ ft. after ____ hrs. pumping ____ g.p.m. Estimated maximum yield <b>5</b> g.p.m.		
			13. Water sample submitted: <input type="checkbox"/> Yes <input checked="" type="checkbox"/> No Date _____		
			14. Well head completion: <b>CAP</b> <input type="checkbox"/> Pitless adapter <b>28</b> inches above grade		
			15. Well grouted? <input checked="" type="checkbox"/> With: <input checked="" type="checkbox"/> Neat cement <input type="checkbox"/> Bentonite <input type="checkbox"/> Concrete Depth: From <b>5</b> ft. to <b>15</b> ft.		
			16. Nearest source of possible contamination: ft. <b>300</b> Direction <b>S</b> Type <b>SEPTIC</b> Well disinfected upon completion? <input checked="" type="checkbox"/> Yes <input type="checkbox"/> No		
			17. Pump: <input checked="" type="checkbox"/> Not installed Manufacturer's name _____ Model number _____ HP _____ Volts _____ Length of drop pipe _____ ft. capacity _____ g.p.m. Type: <input type="checkbox"/> Submersible <input type="checkbox"/> Turbine <input type="checkbox"/> Jet <input type="checkbox"/> Reciprocating <input type="checkbox"/> Centrifugal <input type="checkbox"/> Other		
(Use a second sheet if needed)					
18. Elevation:		19. Remarks: <b>OWNER WILL INSTAL SLAB</b>		20. Water well contractor's certification: This well was drilled under my jurisdiction and this report is true to the best of my knowledge and belief. <b>Stander Orlay Co Inc 182</b> Business name License No. _____ Address <b>RT 1 Holton, KS</b> Signed <b>Dale Orlay</b> Date <b>9-16-76</b> Authorized representative	

T  
R  
W  
S  
1/4  
1/4  
1/4

Forward the white, blue and pink copies to the Department of Health and Environment

Form WWC-5