


1 LOCATION OF WATER WELL: County: RILEY C Fraction: SW 1/4 NE 1/4 NW 1/4 Section Number: 34 Township Number: T 10 S Range Number: R 7 E/W

Distance and direction from nearest town or city street address of well if located within city?

2 WATER WELL OWNER: USDA SOIL CONSERVATION CENTER
RR#, St. Address, Box #: PLANT MATERIALS CENTER 3800 S. 20TH ST. Board of Agriculture, Division of Water Resources
City, State, ZIP Code: MANHATTAN KS 66502 Application Number:

3 LOCATE WELL'S LOCATION WITH AN "X" IN SECTION BOX:

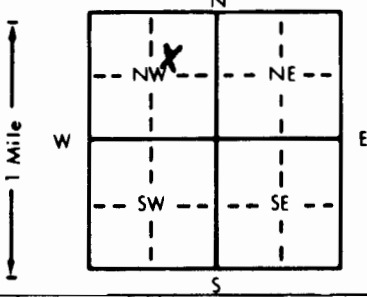

4 DEPTH OF COMPLETED WELL: 40 ft. ELEVATION:
Depth(s) Groundwater Encountered 1. 25 ft. 2. ft. 3. ft.
WELL'S STATIC WATER LEVEL: 25 ft. below land surface measured on mo/day/yr
Pump test data: Well water was ft. after hours pumping gpm
Est. Yield gpm: Well water was ft. after hours pumping gpm
Bore Hole Diameter: in. to ft., and in. to ft.
WELL WATER TO BE USED AS: 5 Public water supply 8 Air conditioning 11 Injection well
1 Domestic 3 Feedlot 6 Oil field water supply 9 Dewatering 12 Other (Specify below)
(2) Irrigation 4 Industrial 7 Lawn and garden only 10 Monitoring well
Was a chemical/bacteriological sample submitted to Department? Yes No ; If yes, mo/day/yr sample was submitted
Water Well Disinfected? (Yes) No

5 TYPE OF BLANK CASING USED: 1 Steel 3 RMP (SR) 5 Wrought iron 8 Concrete tile CASING JOINTS: Glued Clamped
2 PVC 4 ABS 6 Asbestos-Cement (9) Other (specify below) Welded
Blank casing diameter: 5 in. to CUT OFF Dia. 3' Below Ground in. to ft. Dia in. to ft.
Casing height above land surface: in., weight lbs./ft. Wall thickness or gauge No.
TYPE OF SCREEN OR PERFORATION MATERIAL: 7 PVC 10 Asbestos-cement
1 Steel 3 Stainless steel 5 Fiberglass 8 RMP (SR) 11 Other (specify)
2 Brass 4 Galvanized steel 6 Concrete tile 9 ABS 12 None used (open hole)
SCREEN OR PERFORATION OPENINGS ARE: 5 Gauzed wrapped 8 Saw cut 11 None (open hole)
1 Continuous slot 3 Mill slot 6 Wire wrapped 9 Drilled holes
2 Louvered shutter 4 Key punched 7 Torch cut 10 Other (specify)
SCREEN-PERFORATED INTERVALS: From ft. to ft. From ft. to ft.
GRAVEL PACK INTERVALS: From ft. to ft. From ft. to ft.
From 25 ft. to 40 ft. From ft. to ft.

6 GROUT MATERIAL: 1 Neat cement 2 Cement grout (4) Bentonite 4 Other
Grout Intervals: From 0 ft. to 25 ft. From ft. to ENVIROPLUG From ft. to ft.
What is the nearest source of possible contamination: PLUGGED 10 Livestock pens 14 Abandoned water well
1 Septic tank 4 Lateral lines 7 Pit privy 11 Fuel storage 15 Oil well/Gas well
2 Sewer lines 5 Cess pool 8 Sewage lagoon 12 Fertilizer storage 16 Other (specify below)
3 Watertight sewer lines 6 Seepage pit 9 Feedyard 13 Insecticide storage

Direction from well? How many feet?

FROM	TO	LITHOLOGIC LOG	FROM	TO	PLUGGING INTERVALS
<u>0</u>	<u>25</u>	<u>ENVIROPLUG</u>			
<u>25</u>	<u>40</u>	<u>CLORINATED SAND</u>			

PLUGGED

7 CONTRACTOR'S OR LANDOWNER'S CERTIFICATION: This water well was (1) constructed, (2) reconstructed, or (3) plugged under my jurisdiction and was completed on (mo/day/year) 10 / 12 / 90 and this record is true to the best of my knowledge and belief. Kansas Water Well Contractor's License No. 451 This Water Well Record was completed on (mo/day/yr) 10 / 23 / 90 under the business name of HALDEMAN WELL DRILLING by (signature) Craig H. CUDRPE

OFFICE USE ONLY
T
R
EW
SEC.
1/4
1/4
1/4