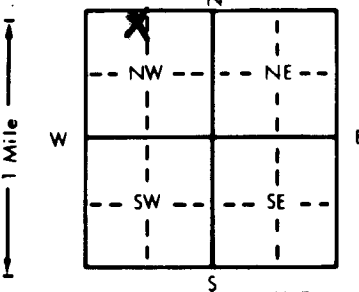


1 LOCATION OF WATER WELL: Fraction W 1/2 NE 1/4 NW 1/4 NW 1/4 Section Number 34 Township Number T 10 S Range Number R 7 EW
 County: RILEY
 Distance and direction from nearest town or city street address of well if located within city?

2 WATER WELL OWNER: USDA SOIL CONSERVATION
 RR#, St. Address, Box # : PLANT MATERIALS CENTER 3800 S. 20th ST. Board of Agriculture, Division of Water Resources
 City, State, ZIP Code : MANHATTAN KS 66502 Application Number:

3 LOCATE WELL'S LOCATION WITH AN "X" IN SECTION BOX:

 4 DEPTH OF COMPLETED WELL: 50 ft. ELEVATION:
 Depth(s) Groundwater Encountered 1. 25 ft. 2. . ft. 3. . ft.
 WELL'S STATIC WATER LEVEL: 25 ft. below land surface measured on mo/day/yr
 Pump test data: Well water was . ft. after . hours pumping . gpm
 Est. Yield . gpm: Well water was . ft. after . hours pumping . gpm
 Bore Hole Diameter . in. to . ft., and . in. to . ft.
 WELL WATER TO BE USED AS:
 5 Public water supply 8 Air conditioning 11 Injection well
 1 Domestic 3 Feedlot 6 Oil field water supply 9 Dewatering 12 Other (Specify below)
2 Irrigation 4 Industrial 7 Lawn and garden only 10 Monitoring well
 Was a chemical/bacteriological sample submitted to Department? Yes.....No.....; If yes, mo/day/yr sample was sub-
 mitted Water Well Disinfected? Yes No

5 TYPE OF BLANK CASING USED:
 1 Steel 3 RMP (SR) 5 Wrought iron 8 Concrete tile CASING JOINTS: Glued Clamped
 2 PVC 4 ABS 6 Asbestos-Cement 9 Other (specify below) Welded
 7 Fiberglass GALVANIZED Threaded
 Blank casing diameter . 10 in. to CUT OFF 3' Dia below Grade to . ft., Dia . in. to . ft.
 Casing height above land surface . in., weight . lbs./ft. Wall thickness or gauge No.
 TYPE OF SCREEN OR PERFORATION MATERIAL:
 1 Steel 3 Stainless steel 5 Fiberglass 8 RMP (SR) 10 Asbestos-cement
 2 Brass 4 Galvanized steel 6 Concrete tile 9 ABS 12 None used (open hole)
 SCREEN OR PERFORATION OPENINGS ARE:
 1 Continuous slot 3 Mill slot 5 Gauzed wrapped 8 Saw cut 11 None (open hole)
 2 Louvered shutter 4 Key punched 7 Torch cut 9 Drilled holes
 SCREEN-PERFORATED INTERVALS: From . ft. to . ft., From . ft. to . ft.
 From . ft. to . ft., From . ft. to . ft.
 GRAVEL PACK INTERVALS: From . 25 ft. to . 50 ft., From . ft. to . ft.
 From . ft. to . ft., From . ft. to . ft.

6 GROUT MATERIAL: 1 Neat cement 2 Cement grout 3 Bentonite 4 Other
 Grout Intervals: From . 0 ft. to . 25 ft., From . ft. to . ENVIROPLUG ft. to . ft.
 What is the nearest source of possible contamination: PLUGGED
 1 Septic tank 4 Lateral lines 7 Pit privy 10 Livestock pens 14 Abandoned water well
 2 Sewer lines 5 Cess pool 8 Sewage lagoon 11 Fuel storage 15 Oil well/Gas well
 3 Watertight sewer lines 6 Seepage pit 9 Feedyard 12 Fertilizer storage 16 Other (specify below)
 13 Insecticide storage
 Direction from well? How many feet?

FROM	TO	LITHOLOGIC LOG	FROM	TO	PLUGGING INTERVALS
0	25	ENVIROPLUG			
25	50	CLORINATED SAND			
PLUGGED					

7 CONTRACTOR'S OR LANDOWNER'S CERTIFICATION: This water well was (1) constructed, (2) reconstructed, or (3) plugged under my jurisdiction and was completed on (mo/day/year) 10/12/90 and this record is true to the best of my knowledge and belief. Kansas Water Well Contractor's License No. 451. This Water Well Record was completed on (mo/day/yr) 10/22/90 under the business name of HALDEMAN WELL DRILLING by (signature) Craig CWAPE

OFFICE USE ONLY
T
R
EW
SEC.
1/4
1/4
1/4