


1 LOCATION OF WATER WELL: County: Riley Fraction: SE 1/4 NE 1/4 SE 1/4 Section Number: 36 Township Number: T 10 S Range Number: R 7 EW

Distance and direction from nearest town or city street address of well if located within city?

2 South of Manhattan

2 WATER WELL OWNER: Public Works Department Board of Agriculture, Division of Water Resources
 RR#, St. Address, Box #: Riley County Application Number:
 City, State, ZIP Code: Courthouse, Manhattan, Kansas 66502

3 LOCATE WELL'S LOCATION WITH AN "X" IN SECTION BOX: 4 DEPTH OF COMPLETED WELL: 36 ft. ELEVATION:

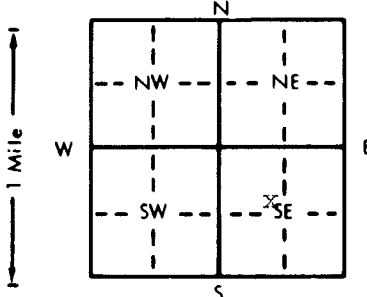

Depth(s) Groundwater Encountered 1. ft. 2. ft. 3. ft.
 WELL'S STATIC WATER LEVEL 14 ft. below land surface measured on mo/day/yr May 16, 1983
 Pump test data: Well water was NA ft. after hours pumping gpm
 Est. Yield 25 gpm: Well water was ft. after hours pumping gpm
 Bore Hole Diameter 12 in. to 23 ft., and 8 in. to 36 ft.
 WELL WATER TO BE USED AS: 5 Public water supply 8 Air conditioning 11 Injection well
 1 Domestic 3 Feedlot 6 Oil field water supply 9 Dewatering *well to be used for building at site
 2 Irrigation 4 Industrial 7 Lawn and garden only 10 Observation well
 Was a chemical/bacteriological sample submitted to Department? Yes.....No X.....; If yes, mo/day/yr sample was submitted
 Water Well Disinfected? Yes X No

5 TYPE OF BLANK CASING USED: X1 Steel 3 RMP (SR) 6 Asbestos-Cement 9 Other (specify below) Welded

Blank casing diameter 8 in. to 23 ft., Dia 5 in. to 36 ft., Dia in. to ft.
 Casing height above land surface P. UNIT 36 in., weight 8" 25# + 5" 3# lbs./ft. Wall thickness or gauge No. 5" .258

TYPE OF SCREEN OR PERFORATION MATERIAL: XXX7 PVC 10 Asbestos-cement
 1 Steel 3 Stainless steel 5 Fiberglass 8 RMP (SR) 11 Other (specify)
 2 Brass 4 Galvanized steel 6 Concrete tile 9 ABS 12 None used (open hole)

SCREEN OR PERFORATION OPENINGS ARE: 5 Gauzed wrapped XXX8 Saw cut 11 None (open hole)
 1 Continuous slot 3 Mill slot 6 Wire wrapped 9 Drilled holes
 2 Louvered shutter 4 Key punched 7 Torch cut 10 Other (specify)

SCREEN-PERFORATED INTERVALS: From 26 ft. to 36 ft., From ft. to ft.
 GRAVEL PACK INTERVALS: From 23 ft. to 36 ft., From ft. to ft.

6 GROUT MATERIAL: XXXX Neat cement 2 Cement grout 3 Bentonite 4 Other

Grout Intervals: From 3 ft. to 23 ft., From ft. to ft.
 What is the nearest source of possible contamination:
 1 Septic tank 4 Lateral lines 7 Pit privy 10 Livestock pens 14 Abandoned water well
 2 Sewer lines 5 Cess pool 8 Sewage lagoon 11 Fuel storage 15 Oil well/Gas well
 3 Watertight sewer lines 6 Seepage pit 9 Feedyard 12 Fertilizer storage 16 Other (specify below)
 Direction from well? all directions How many feet? Well drilled over a landfill area

FROM	TO	LITHOLOGIC LOG	FROM	TO	LITHOLOGIC LOG
0	3	land fill w/ topsoil			
3	17	trash (paper etc)			
17	21	silt			
21	26 38	gravel			
26					
38	40	blue shale			
40		stop			

7 CONTRACTOR'S OR LANDOWNER'S CERTIFICATION: This water well was (X) constructed, (2) reconstructed, or (3) plugged under my jurisdiction and was completed on (mo/day/year) May 16, 1983 and this record is true to the best of my knowledge and belief. Kansas Water Well Contractor's License No. 359. This Water Well Record was completed on (mo/day/yr) May 20, 1983 under the business name of Daryl Cox & Sons Inc. by (signature) Daryl Cox

INSTRUCTIONS: Use typewriter or ball point pen, PLEASE PRESS FIRMLY and PRINT clearly. Please fill in blanks, underline or circle the correct answers. Send top three copies to Kansas Department of Health and Environment, Division of Environment, Environmental Geology Section, Topeka, KS 66620. Send one to WATER WELL OWNER and retain one for your records.

OFFICE USE ONLY T 10 R 7 (EW) SEC. 36 SE 1/4 NE 1/4 SE 1/4