


1 LOCATION OF WATER WELL: County: Riley Co. Fraction 1/4 SE 1/4 NE 1/4 Section Number 36 Township Number T 10 S Range Number R 7 E

Distance and direction from nearest town or city street address of well if located within city? Riley Co Landfill  
I will send Revised map when completed K. R. E. Landfill

2 WATER WELL OWNER: Riley Co. RR#, St. Address, Box #: Riley County Court House Board of Agriculture, Division of Water Resources  
 City, State, ZIP Code: Manhattan, Kansas 66502 Application Number:

3 LOCATE WELL'S LOCATION WITH AN "X" IN SECTION BOX:

4 DEPTH OF COMPLETED WELL: 40 ft. ELEVATION:  
 Depth(s) Groundwater Encountered 1. 18 ft. 2. . ft. 3. . ft.  
 WELL'S STATIC WATER LEVEL 18' ft. below land surface measured on mo/day/yr  
 Pump test data: Well water was . ft. after . hours pumping . gpm  
 Est. Yield 40 gpm: Well water was . ft. after . hours pumping . gpm  
 Bore Hole Diameter 6 in. to 40' ft., and . in. to . ft.  
 WELL WATER TO BE USED AS:  
 5 Public water supply 8 Air conditioning 11 Injection well  
 1 Domestic 3 Feedlot 6 Oil field water supply 9 Dewatering 12 Other (Specify below)  
 2 Irrigation 4 Industrial 7 Lawn and garden only 10 Observation well Monitoring  
 Was a chemical/bacteriological sample submitted to Department? Yes . No ; If yes, mo/day/yr sample was submitted  
 Water Well Disinfected? Yes . No

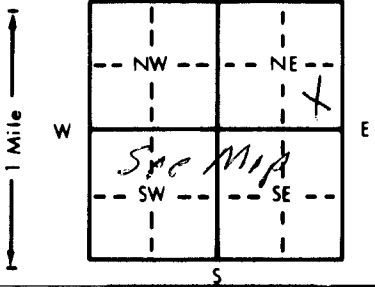

5 TYPE OF BLANK CASING USED:  
 1 Steel FLUSH JOINT 3 RMP (SR) 6 Asbestos-Cement 9 Other (specify below) Welded  
 2 PVC FLUSH JOINT 4 ABS 7 Fiberglass Threaded  
 Blank casing diameter 4" in. to 30' ft., Dia . in. to . ft., Dia . in. to . ft.  
 Casing height above land surface 3' in., weight 50.5 lb lbs./ft. Wall thickness or gauge No. .

TYPE OF SCREEN OR PERFORATION MATERIAL:  
 1 Steel 3 Stainless steel 5 Fiberglass 7 PVC FLUSH JOINT 10 Asbestos-cement  
 2 Brass 4 Galvanized steel 6 Concrete tile 8 RMP (SR) 11 Other (specify) .  
 12 None used (open hole)

SCREEN OR PERFORATION OPENINGS ARE:  
 1 Continuous slot 3 Mill slot 16/1000's 5 Gauzed wrapped 8 Saw cut 11 None (open hole)  
 2 Louvered shutter 4 Key punched 6 Wire wrapped 9 Drilled holes  
 7 Torch cut 10 Other (specify) .

SCREEN-PERFORATED INTERVALS: From 30 ft. to 40 ft., From . ft. to . ft.  
 From . ft. to . ft., From . ft. to . ft.  
 GRAVEL PACK INTERVALS: From 10 ft. to 40 ft., From . ft. to . ft.  
 From . ft. to . ft., From . ft. to . ft.

6 GROUT MATERIAL: 1 Neat cement MONITORING Cement grout 3 Bentonite 4 Other Volclay Pellets 4"  
 Grout Intervals: From 0 ft. to 10 ft., From . ft. to . ft., From . ft. to . ft.

What is the nearest source of possible contamination:  
 1 Septic tank 4 Lateral lines 7 Pit privy 10 Livestock pens 14 Abandoned water well  
 2 Sewer lines 5 Cess pool 8 Sewage lagoon 11 Fuel storage 15 Oil well/Gas well  
 3 Watertight sewer lines 6 Seepage pit 9 Feedyard 12 Fertilizer storage 16 Other (specify below)  
 13 Insecticide storage

Direction from well? How many feet?

FROM	TO	LITHOLOGIC LOG	FROM	TO	LITHOLOGIC LOG
0	3	CLAY			
3	20	Fine Sand			
20	30	Median Sand			
30	40	Coarse Sand			

7 CONTRACTOR'S OR LANDOWNER'S CERTIFICATION: This water well was (1) constructed (2) reconstructed, or (3) plugged under my jurisdiction and was completed on (mo/day/year) 10/18/87 and this record is true to the best of my knowledge and belief. Kansas Water Well Contractor's License No. 451 This Water Well Record was completed on (mo/day/yr) 10/29/87 under the business name of Haldeman Well Drilling by (signature) Craig Hall CWDP

OFFICE USE ONLY