


1 LOCATION OF WATER WELL: County: Riley Fraction: NE 1/4 SW 1/4 NE 1/4 Section Number: 36 Township Number: T 10 S Range Number: R 7 E/W

Distance and direction from nearest town or city street address of well if located within city?

2 WATER WELL OWNER: Riley County 110 COURTHOUSE PLAZA Board of Agriculture, Division of Water Resources City, State, ZIP Code: MANHATTAN KS 66501 Application Number:

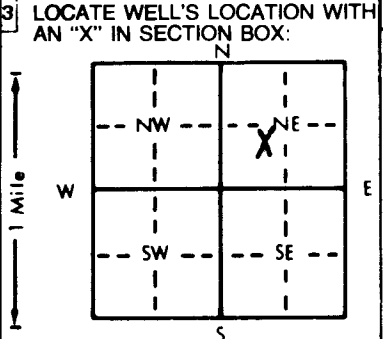

3 LOCATE WELL'S LOCATION WITH AN 'X' IN SECTION BOX: 4 DEPTH OF COMPLETED WELL: 22.0 ft. ELEVATION: Depth(s) Groundwater Encountered: 1. 12.0 ft. 2. WELL'S STATIC WATER LEVEL: 16.5 ft. below land surface measured on mo/day/yr 5-7-91

5 TYPE OF BLANK CASING USED: 1 Steel, 2 PVC, 3 RMP (SR), 4 ABS, 5 Wrought iron, 6 Asbestos-Cement, 7 Fiberglass, 8 Concrete tile, 9 Other (specify below), 10 Asbestos-cement, 11 Injection well, 12 Other (Specify below) CASING JOINTS: Glued, Clamped, Welded, Threaded. Blank casing diameter: 4 in. to 12.0 ft., Dia. Casing height above land surface: 36 in., weight 50 lb. Type of screen or perforation material: 1 Steel, 2 Brass, 3 Stainless steel, 4 Galvanized steel, 5 Fiberglass, 6 Concrete tile, 7 RMP (SR), 8 ABS, 9 PVC, 10 Asbestos-cement, 11 Other (specify), 12 None used (open hole) SCREEN OR PERFORATION OPENINGS ARE: 1 Continuous slot, 2 Louvered shutter, 3 Mill slot, 4 Key punched, 5 Gauzed wrapped, 6 Wire wrapped, 7 Torch cut, 8 Saw cut, 9 Drilled holes, 10 Other (specify), 11 None (open hole) SCREEN-PERFORATED INTERVALS: From 22.0 ft. to 12.0 ft., From GRAVEL PACK INTERVALS: From 22.5 ft. to 9.5 ft., From

6 GROUT MATERIAL: 1 Neat cement, 2 Cement grout, 3 Bentonite, 4 Other Grout Intervals: From 0 ft. to 3.0 ft., From 3.0 ft. to 9.5 ft., From What is the nearest source of possible contamination: 1 Septic tank, 2 Sewer lines, 3 Watertight sewer lines, 4 Lateral lines, 5 Cess pool, 6 Seepage pit, 7 Pit privy, 8 Sewage lagoon, 9 Feedyard, 10 Livestock pens, 11 Fuel storage, 12 Fertilizer storage, 13 Insecticide storage, 14 Abandoned water well, 15 Oil well/Gas well, 16 Other (specify below) LANDFILL

Direction from well? How many feet? LITHOLOGIC LOG: FROM TO SANDY SILT, FINE-MED SAND, LOOSE SAND PLUGGING INTERVALS

7 CONTRACTOR'S OR LANDOWNER'S CERTIFICATION: This water well was (1) constructed, (2) reconstructed, or (3) plugged under my jurisdiction and was completed on (mo/day/year) 5-7-91 and this record is true to the best of my knowledge and belief. Kansas Water Well Contractor's License No. 416 This Water Well Record was completed on (mo/day/yr) 5-7-91 under the business name of Ferracon Consultants by (signature) EL [Signature]