


1 LOCATION OF WATER WELL: Fraction NE 1/4 NE 1/4 NE 1/4 Section Number 36 Township Number T 10 S Range Number R 7 E
 County: Riley

Distance and direction from nearest town or city street address of well if located within city? 2 miles South on Huntis Island Rd. from Manhattan

2 WATER WELL OWNER: Boyer Const
 RR#, St. Address, Box #: 120 Deep Creek Rd.
 City, State, ZIP Code: Manhattan, KS 66502
 Board of Agriculture, Division of Water Resources
 Application Number: 920175

3 LOCATE WELL'S LOCATION WITH AN "X" IN SECTION BOX:

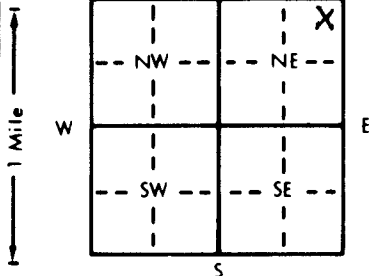

4 DEPTH OF COMPLETED WELL: 4.8 ft. ELEVATION: WIS
 Depth(s) Groundwater Encountered: 1. 1.2 ft. 2. _____ ft. 3. _____ ft.
 WELL'S STATIC WATER LEVEL: 12 ft. below land surface measured on mo/day/yr

WIS Pump test data: Well water was _____ ft. after _____ hours pumping _____ gpm
 Est. Yield: 500 gpm; Well water was _____ ft. after _____ hours pumping _____ gpm
 Bore Hole Diameter: WIS ~~1.5~~ in. to _____ ft., and _____ in. to _____ ft.

WELL WATER TO BE USED AS:
 5 Public water supply 8 Air conditioning 11 Injection well
 1 Domestic 3 Feedlot 6 Oil field water supply 9 Dewatering WIS = 12 Other (Specify below) TEMP CONSTRUCTION WELLS
 2 Irrigation 4 Industrial 7 Lawn and garden only 10 Monitoring well
 Was a chemical/bacteriological sample submitted to Department? Yes _____ No _____; If yes, mo/day/yr sample was submitted _____
 Water Well Disinfected? Yes ✓ No _____

5 TYPE OF BLANK CASING USED:
 1 Steel 3 RMP (SR) 5 Wrought iron 8 Concrete tile CASING JOINTS: Glued _____ Clamped _____
 2 PVC was 4 ABS 7 Fiberglass _____ Welded _____
 Blank casing diameter: 6 in. to _____ ft., Dia. _____ in. to _____ ft., Dia. _____ in. to _____ ft.
 Casing height above land surface: Cut off 3' below grade lbs./ft. Wall thickness or gauge No. _____

TYPE OF SCREEN OR PERFORATION MATERIAL:
 1 Steel 3 Stainless steel 5 Fiberglass 8 RMP (SR) 10 Asbestos-cement
 2 Brass 4 Galvanized steel 6 Concrete tile 9 ABS 11 Other (specify) NA
 12 None used (open hole)

SCREEN OR PERFORATION OPENINGS ARE:
 1 Continuous slot 3 Mill slot 5 Gauzed wrapped 8 Saw cut 11 None (open hole)
 2 Louvered shutter 4 Key punched 6 Wire wrapped 9 Drilled holes
 7 Torch cut 10 Other (specify) NA

SCREEN-PERFORATED INTERVALS: From _____ ft. to _____ ft., From _____ ft. to _____ ft.
 GRAVEL PACK INTERVALS: From 2.0 ft. to 4.8 ft., From _____ ft. to _____ ft.

6 GROUT MATERIAL: 1 Neat cement 2 Cement grout 3 Bentonite 4 Other _____
 Grout Intervals: From 3 ft. to 20 ft., From _____ ft. to _____ ft., From _____ ft. to _____ ft.

What is the nearest source of possible contamination:
 1 Septic tank 4 Lateral lines 7 Pit privy 10 Livestock pens 14 Abandoned water well
 2 Sewer lines 5 Cess pool 8 Sewage lagoon 11 Fuel storage 15 Oil well/Gas well
 3 Watertight sewer lines 6 Seepage pit 9 Feedyard 12 Fertilizer storage 16 Other (specify below) _____
 13 Insecticide storage _____

Direction from well? _____ How many feet? _____

| FROM | TO | LITHOLOGIC LOG | FROM | TO | PLUGGING INTERVALS |
|----------------|----|-------------------|------|----|--------------------|
| 0 | 3 | Compacted Clay | | | |
| 3 | 20 | Bentonite Grout | | | |
| 20 | 48 | Classified Gravel | | | |
| <u>Plugged</u> | | | | | |

7 CONTRACTOR'S OR LANDOWNER'S CERTIFICATION: This water well was (1) constructed, (2) reconstructed, or (3) plugged under my jurisdiction and was completed on (mo/day/year) 6/15/93 and this record is true to the best of my knowledge and belief. Kansas Water Well Contractor's License No. 451 This Water Well Record was completed on (mo/day/yr) 6/25/93
 under the business name of Haldeman Well Drilling by (signature) Craig J. Cooper

OFFICE USE ONLY
T
R
E
M
SEC.