


1 LOCATION OF WATER WELL: Fraction $\frac{1}{4}$ NW $\frac{1}{4}$ NW $\frac{1}{4}$ Section Number 5 Township Number T 10 (S) Range Number R 7 (E/W)
 County: Riley

Distance and direction from nearest town or city street address of well if located within city? From Manhattan in 4 miles west on Riley County 412 + 1/2 mile north

2 WATER WELL OWNER: Robert Clark
 RR#, St. Address, Box #: 5524 Anderson Ave.
 City, State, ZIP Code: Manhattan, Kansas 66502
 Board of Agriculture, Division of Water Resources
 Application Number:

3 LOCATE WELL'S LOCATION WITH AN "X" IN SECTION BOX:

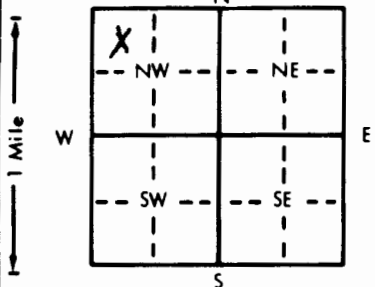

4 DEPTH OF COMPLETED WELL: 80' ft. ELEVATION:

Depth(s) Groundwater Encountered 1. 67' ft. 2. ft. 3. ft.
 WELL'S STATIC WATER LEVEL: 50' ft. below land surface measured on mo/day/yr
 Pump test data: Well water was ft. after hours pumping gpm
 Est. Yield 100.0 gpm; Well water was ft. after hours pumping gpm
 Bore Hole Diameter: 8" in. to 80' ft., and in. to ft.
 WELL WATER TO BE USED AS:
 1 Domestic (circled) 3 Feedlot 6 Oil field water supply 9 Dewatering 12 Other (Specify below)
 2 Irrigation 4 Industrial 7 Lawn and garden only 10 Monitoring well
 Was a chemical/bacteriological sample submitted to Department? Yes.....No..... If yes, mo/day/yr sample was submitted

5 TYPE OF BLANK CASING USED:
 1 Steel 3 RMP (SR) 5 Wrought iron 8 Concrete tile CASING JOINTS: Glued (circled) Clamped
 2 PVC (circled) 4 ABS 6 Asbestos-Cement 9 Other (specify below) Welded
 7 Fiberglass Threaded.

Blank casing diameter: 5" in. to 60' ft., Dia. in. to ft., Dia. in. to ft.
 Casing height above land surface: 2' in., weight: Sch 40 lbs./ft. Wall thickness or gauge No.

TYPE OF SCREEN OR PERFORATION MATERIAL:
 1 Steel 3 Stainless steel 5 Fiberglass 8 RMP (SR) 10 Asbestos-cement
 2 Brass 4 Galvanized steel 6 Concrete tile 9 ABS 11 Other (specify)
 12 None used (open hole)

SCREEN OR PERFORATION OPENINGS ARE:
 1 Continuous slot 3 Mill slot (circled) 31/1000's 5 Gauzed wrapped 8 Saw cut 11 None (open hole)
 2 Louvered shutter 4 Key punched 6 Wire wrapped 9 Drilled holes 10 Other (specify)

SCREEN-PERFORATED INTERVALS: From 60 ft. to 80 ft., From ft. to ft.
 GRAVEL PACK INTERVALS: From 20 ft. to 80 ft., From ft. to ft.

6 GROUT MATERIAL: 1 Neat cement 2 Cement grout 3 Bentonite (circled) 4 Other
 Grout Intervals: From 0 ft. to 20 ft., From ft. to ft.

What is the nearest source of possible contamination: None close
 1 Septic tank 4 Lateral lines 7 Pit privy 10 Livestock pens 14 Abandoned water well
 2 Sewer lines 5 Cess pool 8 Sewage lagoon 11 Fuel storage 15 Oil well/Gas well
 3 Watertight sewer lines 6 Seepage pit 9 Feedyard 12 Fertilizer storage 16 Other (specify below)
 13 Insecticide storage

Direction from well? How many feet?

FROM	TO	LITHOLOGIC LOG	FROM	TO	PLUGGING INTERVALS
0	22	Brown Clay	78	79	Gray Shale
22	26	Rock	79	80	Rock
26	29	Brown Clay			
29	30	Rock			
30	36	Greenish Shale			
36	41	Brown Shale			
41	46	Rock			
46	50	Gray Shale			
50	52	Rock			
52	55	Brown Shale			
55	64	Rock			
64	67	Brown Shale			
67	70	Rock			
70	77	Gray Shale			
77	78	Rock			

7 CONTRACTOR'S OR LANDOWNER'S CERTIFICATION: This water well was (1) constructed (circled) (2) reconstructed, or (3) plugged under my jurisdiction and was completed on (mo/day/year) 5/23/88 and this record is true to the best of my knowledge and belief. Kansas Water Well Contractor's License No. 451 This Water Well Record was completed on (mo/day/yr) 6/19/88 under the business name of Haldeman Well Drilling by (signature) Craig H. Haldeman