


1 LOCATION OF WATER WELL: County: Riley Fraction: NW 1/4 SE 1/4 NE 1/4 Section Number: 2 Township Number: T 10 S Range Number: R 7 E/W

Distance and direction from nearest town or city street address of well if located within city? in Manhattan on Browning Avt.

2 WATER WELL OWNER: Manhattan School Dist & Boyers Coast
 RR#, St. Address, Box #: Riley County School Dist Board of Agriculture, Division of Water Resources
 City, State, ZIP Code: Manhattan, KS 66502 Application Number:

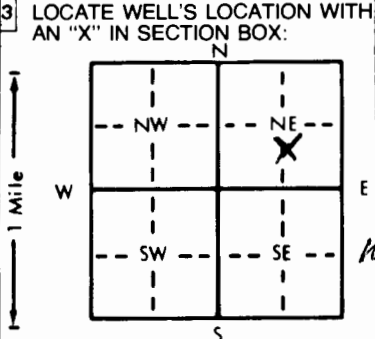

4 DEPTH OF COMPLETED WELL: WAS 70' ft. ELEVATION:
 Depth(s) Groundwater Encountered: 1. WAS 40' ft. 2. ft. 3. ft.
 WELL'S STATIC WATER LEVEL WAS 40' ft. below land surface measured on mo/day/yr
 Pump test data: Well water was ft. after hours pumping gpm
 Est. Yield 20 gpm: Well water was ft. after hours pumping gpm
 Bore Hole Diameter: WAS 12" in. to ft., and in. to ft.
 WELL WATER TO BE USED AS:
 1 Domestic WAS 3 Feedlot 6 Oil field water supply 9 Dewatering 12 Other (Specify below)
 2 Irrigation 4 Industrial 7 Lawn and garden only 10 Monitoring well
 Was a chemical/bacteriological sample submitted to Department? Yes..... No..... If yes, mo/day/yr sample was submitted
 Water Well Disinfected? Yes No

5 TYPE OF BLANK CASING USED:
 1 Steel 3 RMP (SR) 5 Wrought iron 8 Concrete tile CASING JOINTS: Glued Clamped
 2 PVC 4 ABS WAS 8" STAL 6 Asbestos-Cement 9 Other (specify below) Welded
 7 Fiberglass NONE Threaded
 Blank casing diameter WAS 8" in. to Dia in. to ft. Dia in. to ft.
 Casing height above land surface NONE NA in., weight lbs./ft. Wall thickness or gauge No.
 TYPE OF SCREEN OR PERFORATION MATERIAL:
 1 Steel 3 Stainless steel WAS Pulled out 5 Fiberglass 7 PVC 10 Asbestos-cement
 2 Brass 4 Galvanized steel 6 Concrete tile 9 ABS 11 Other (specify) NA
 12 None used (open hole)
 SCREEN OR PERFORATION OPENINGS ARE:
 1 Continuous slot 3 Mill slot WAS Pulled out 5 Gauzed wrapped 8 Saw cut 11 None (open hole)
 2 Louvered shutter 4 Key punched WAS Pulled out 6 Wire wrapped 9 Drilled holes
 7 Torch cut 10 Other (specify) NA
 SCREEN-PERFORATED INTERVALS: From ft. to ft., From ft. to ft.
 GRAVEL PACK INTERVALS: From 40' ft. to 70' ft., From ft. to ft.

6 GROUT MATERIAL: 1 Neat cement 2 Cement grout 3 Bentonite 4 Other
 Grout Intervals: From 3 ft. to 40 ft., From ft. to ft., From ft. to ft.
 What is the nearest source of possible contamination: NONE CLOSE
 1 Septic tank 4 Lateral lines 7 Pit privy 10 Livestock pens 14 Abandoned water well
 2 Sewer lines 5 Cess pool 8 Sewage lagoon 11 Fuel storage 15 Oil well/Gas well
 3 Watertight sewer lines 6 Seepage pit 9 Feedyard 12 Fertilizer storage 16 Other (specify below)
 13 Insecticide storage
 Direction from well? How many feet?

FROM	TO	LITHOLOGIC LOG	FROM	TO	PLUGGING INTERVALS
0	3	Compacted clay			
3	40	BENTONITE GROUT			
40	70	CLORINATED SAND & GRAVEL			
Plugged					

7 CONTRACTOR'S OR LANDOWNER'S CERTIFICATION: This water well was (1) constructed, (2) reconstructed, or (3) plugged under my jurisdiction and was completed on (mo/day/year) 10/26/94 and this record is true to the best of my knowledge and belief. Kansas Water Well Contractor's License No. 451 This Water Well Record was completed on (mo/day/yr) 10/26/94 under the business name of Halkman Well Drilling by (signature) Craig H. LWP/PS

INSTRUCTIONS: Use typewriter or ball point pen. PLEASE PRESS FIRMLY and PRINT clearly. Please fill in blanks, underline or circle the correct answers. Send top three copies to Kansas Department of Health and Environment, Bureau of Water, Topeka, Kansas 66620-0001. Telephone: 913-296-5545. Send one to WATER WELL OWNER and retain one for your records.

OFFICE USE ONLY
T
R
EW
SEC.
1/4
1/4
1/4