


1 LOCATION OF WATER WELL: County: Riley Fraction SW 1/4 SW 1/4 NE 1/4 Section Number 17 Township Number T 10 S Range Number R 8 EW

Distance and direction from nearest town or city street address of well if located within city? Addition in Manhattan 940 Adams in Fairmont

2 WATER WELL OWNER: Bill Mormon Riley Co. Permit Obtained
 RR#, St. Address, Box #: 940 Adams Board of Agriculture, Division of Water Resources
 City, State, ZIP Code: Manhattan, KS 66502 Application Number:

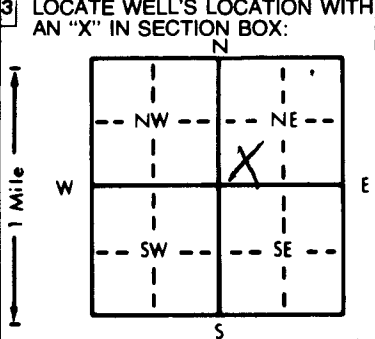

4 DEPTH OF COMPLETED WELL: 33 ft. ELEVATION: ft.
 Depth(s) Groundwater Encountered 1. 17 ft. 2. ft. 3. ft.
 WELL'S STATIC WATER LEVEL 17 ft. below land surface measured on mo/day/yr ft.
 Pump test data: Well water was ft. after hours pumping gpm
 Est. Yield 20 gpm: Well water was ft. after hours pumping gpm
 Bore Hole Diameter 10 in. to 33 ft., and in. to ft.
 WELL WATER TO BE USED AS:
 1 Domestic 3 Feedlot 6 Oil field water supply 9 Dewatering 12 Other (Specify below)
 2 Irrigation 4 Industrial 7 Lawn and garden only 10 Monitoring well
 Was a chemical/bacteriological sample submitted to Department? Yes..... No.....; If yes, mo/day/yr sample was submitted Water Well Disinfected? Yes No

5 TYPE OF BLANK CASING USED:
 1 Steel 3 RMP (SR) 6 Asbestos-Cement 9 Other (specify below) CASING JOINTS: Glued Clamped
 2 PVC 4 ABS 7 Fiberglass Threaded
 Blank casing diameter 5 in. to 20 ft., Dia. in. to ft., Dia. in. to ft.
 Casing height above land surface 2 in., weight 5440 lbs./ft. Wall thickness or gauge No.
 TYPE OF SCREEN OR PERFORATION MATERIAL:
 1 Steel 3 Stainless steel 5 Fiberglass 8 RMP (SR) 10 Asbestos-cement
 2 Brass 4 Galvanized steel 6 Concrete tile 9 ABS 11 Other (specify)
 12 None used (open hole)
 SCREEN OR PERFORATION OPENINGS ARE:
 1 Continuous slot 3 Mill slot 10/3000s 5 Gauzed wrapped 8 Saw cut 11 None (open hole)
 2 Louvered shutter 4 Key punched 6 Wire wrapped 9 Drilled holes
 7 Torch cut 10 Other (specify)
 SCREEN-PERFORATED INTERVALS: From 20 ft. to 33 ft., From ft. to ft.
 GRAVEL PACK INTERVALS: From 20 ft. to 33 ft., From ft. to ft.

6 GROUT MATERIAL: 1 Neat cement 2 Cement grout 3 Bentonite 4 Other
 Grout Intervals: From 0 ft. to 20 ft., From ft. to ft., From ft. to ft.
 What is the nearest source of possible contamination: None Close
 1 Septic tank 4 Lateral lines 7 Pit privy 10 Livestock pens 14 Abandoned water well
 2 Sewer lines 5 Cess pool 8 Sewage lagoon 11 Fuel storage 15 Oil well/Gas well
 3 Watertight sewer lines 6 Seepage pit 9 Feedyard 12 Fertilizer storage 16 Other (specify below)
 13 Insecticide storage
 Direction from well? How many feet?

FROM	TO	LITHOLOGIC LOG	FROM	TO	PLUGGING INTERVALS
0	1	Top Soil			
1	17	Sandy Clay			
17	33	Medium Sand + fine gravel			

7 CONTRACTOR'S OR LANDOWNER'S CERTIFICATION: This water well was (1) constructed, (2) reconstructed, or (3) plugged under my jurisdiction and was completed on (mo/day/year) 11/9/95 and this record is true to the best of my knowledge and belief. Kansas Water Well Contractor's License No. 451 This Water Well Record was completed on (mo/day/year) 12/10/95 under the business name of Holdman Well Drilling by (signature) Craig H. CWD/PE