


1 LOCATION OF WATER WELL: County: Riley Fraction: SE 1/4 SE 1/4 SE 1/4 Section Number: 9 Township Number: T 10 S Range Number: R 8 E  
 Distance and direction from nearest town or city street address of well if located within city? 919 Mission

2 WATER WELL OWNER: Jill S. McGill Riley Co. Permit  
 RR#, St. Address, Box #: 919 Mission Board of Agriculture, Division of Water Resources  
 City, State, ZIP Code: Marion, KS 66502 Application Number:

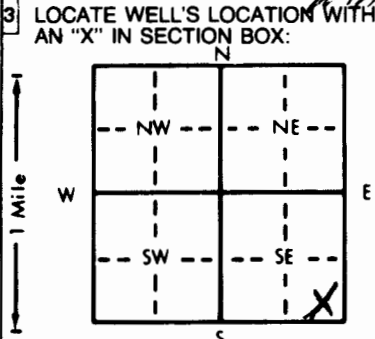

4 DEPTH OF COMPLETED WELL: 160 ft. ELEVATION:  
 Depth(s) Groundwater Encountered 1. 76 ft. 2. ft. 3. ft.  
 WELL'S STATIC WATER LEVEL: 70 ft. below land surface measured on mo/day/yr  
 Pump test data: Well water was ft. after hours pumping gpm  
 Est. Yield 1 gpm: Well water was ft. after hours pumping gpm  
 Bore Hole Diameter: 7 in. to 100 ft., and in. to ft.  
 WELL WATER TO BE USED AS: 5 Public water supply 8 Air conditioning 11 Injection well  
 Domestic 3 Feedlot 6 Oil field water supply 9 Dewatering 12 Other (Specify below)  
 2 Irrigation 4 Industrial 7 Lawn and garden only 10 Monitoring well  
 Was a chemical/bacteriological sample submitted to Department? Yes.....No.....; If yes, mo/day/yr sample was submitted  
 Water Well Disinfected?  Yes  No

5 TYPE OF BLANK CASING USED: 5 Wrought iron 8 Concrete tile CASING JOINTS:  Glued  Clamped  
 1 Steel 3 RMP (SR) 6 Asbestos-Cement 9 Other (specify below) Welded  
 2 PVC 4 ABS 7 Fiberglass Threaded  
 Blank casing diameter: 5 in. to 140 ft., Dia. in. to ft., Dia. in. to ft.  
 Casing height above land surface: 2 in., weight 52340 lbs./ft. Wall thickness or gauge No.  
 TYPE OF SCREEN OR PERFORATION MATERIAL:  7 PVC 10 Asbestos-cement  
 1 Steel 3 Stainless steel 5 Fiberglass 8 RMP (SR) 11 Other (specify)  
 2 Brass 4 Galvanized steel 6 Concrete tile 9 ABS 12 None used (open hole)  
 SCREEN OR PERFORATION OPENINGS ARE: 5 Gauzed wrapped 8 Saw cut 11 None (open hole)  
 1 Continuous slot  3 Mill slot 25/1000's 6 Wire wrapped 9 Drilled holes  
 2 Louvered shutter 4 Key punched 7 Torch cut 10 Other (specify)  
 SCREEN-PERFORATED INTERVALS: From 140 ft. to 160 ft., From ft. to ft.  
 From ft. to ft., From ft. to ft.  
 GRAVEL PACK INTERVALS: From 25 ft. to 160 ft., From ft. to ft.  
 From ft. to ft., From ft. to ft.

6 GROUT MATERIAL: 1 Neat cement 2 Cement grout  3 Bentonite 4 Other  
 Grout intervals: From 0 ft. to 25 ft., From ft. to ft., From ft. to ft.  
 What is the nearest source of possible contamination: None Close  
 1 Septic tank 4 Lateral lines 7 Pit privy 10 Livestock pens 14 Abandoned water well  
 2 Sewer lines 5 Cess pool 8 Sewage lagoon 11 Fuel storage 15 Oil well/Gas well  
 3 Watertight sewer lines 6 Seepage pit 9 Feedyard 12 Fertilizer storage 16 Other (specify below)  
 13 Insecticide storage  
 Direction from well? How many feet?

FROM	TO	LITHOLOGIC LOG	FROM	TO	PLUGGING INTERVALS
0	6	Top Soil			
6	9	Yellow Shale			
9	13	Limestone			
13	21	Yellow Shale			
21	45	Brown Shale			
45	61	Limestone			
61	76	Greenish Shale			
76	84	Limestone			
84	106	Brown Shale (WATER)			
106	110	Limestone			
111	120	Gray Shale			
120	122	Limestone			
122	160	Gray Shale			

7 CONTRACTOR'S OR LANDOWNER'S CERTIFICATION: This water well was  (1) constructed,  (2) reconstructed, or  (3) plugged under my jurisdiction and was completed on (mo/day/year) 9/14/96 and this record is true to the best of my knowledge and belief. Kansas Water Well Contractor's License No. 451 This Water Well Record was completed on (mo/day/yr) 10/14/96 under the business name of Haldeman Wire Drilling by (signature) [Signature]

OFFICE USE ONLY