


1 LOCATION OF WATER WELL: County: Riley Fraction: S2 SE 1/4 SW 1/4 Section Number: 7 Township Number: T 10 S Range Number: R 8 E/W

Distance and direction from nearest town or city street address of well if located within city?

Ward Hall, KSU Campus - Manhattan, Kansas

2 WATER WELL OWNER: Kansas State University RR#: 108 Edwards Hall City, State, ZIP Code: Manhattan, Kansas 66506-4809 Board of Agriculture, Division of Water Resources Application Number:

3 LOCATE WELL'S LOCATION WITH AN "X" IN SECTION BOX:

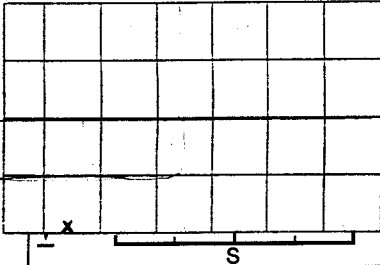

4 DEPTH OF COMPLETED WELL: 47 ft. ELEVATION: 1083.93 Depth(s) Groundwater Encountered: 1. 999 ft. 2. ft. 3. ft. WELL'S STATIC WATER LEVEL: 34.92 ft. below land surface measured on mo/day/yr: 11/26/96

5 TYPE OF BLANK CASING USED: 2 PVC Blank casing diameter: 2 in. to 27 ft. Dia. Casing height above land surface: -2.4 in., weight lbs./ft. Wall thickness or gauge No.: Sch. 40 TYPE OF SCREEN OR PERFORATION MATERIAL: 7 PVC SCREEN OR PERFORATION OPENINGS ARE: 3 Mill slot SCREEN-PERFORATED INTERVALS: From 27 ft. to 47 ft. GRAVEL PACK INTERVALS: From 25 ft. to 47 ft.

6 GROUT MATERIAL: 2 Cement grout 3 Bentonite Grout Intervals: From 0 ft. to 23 ft., From 23 ft. to 25 ft., From ft. to ft. What is the nearest source of possible contamination: 16 Other (specify below): UST Basin

Table with columns: FROM, TO, LITHOLOGIC LOG, FROM, TO, PLUGGING INTERVALS. Rows: 0-2 Clay, Dark Brown; 2-7 Clay, Brown; 7-21 Clay, Dark Brown; 21-37 Sand, Brown; 37-40 Gravel, Brown; 40-47 Shale, Gray.

7 CONTRACTOR'S OR LANDOWNER'S CERTIFICATION: This water well was (1) constructed, (2) reconstructed, or (3) plugged under my jurisdiction and was completed on (mo/day/year) 11/4/96 and this record is true to the best of my knowledge and belief. Kansas Water Well Contractor's License No. 527 This Water Well Record was completed on (mo/day/yr) 12/1/96 under the business name of GeoCore Services, Inc. by (signature) Dale Kobl

INSTRUCTIONS: Use typewriter or ball point pen. PLEASE PRESS FIRMLY and PRINT clearly. Please fill in blanks, underline or circle the correct answers. Send top three copies to Kansas Department of Health and Environment, Bureau of Water, Topeka, Kansas 66620-0001. Telephone: 913-296-5545. Send one to WATER WELL OWNER and retain one for your records.