

1 LOCATION OF WATER WELL: County: Riley Fraction 1/4 NW 1/4 SE 1/4 Section Number 7 Township Number T 10 S Range Number R 8 EW

Distance and direction from nearest town or city street address of well if located within city?

Ward hall, KSU Campus - Manhattan, Kansas


2 WATER WELL OWNER: Kansas State University

RR#, St. Address, Box # : 108 Edwards Hall

Board of Agriculture, Division of Water Resources Application Number:

City, State, ZIP Code : Manhattan, Kansas 66506-4809

3 LOCATE WELL'S LOCATION WITH AN "X" IN SECTION BOX:

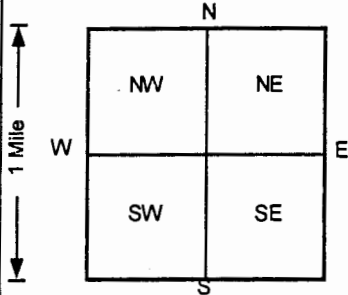

4 DEPTH OF COMPLETED WELL 40 ft. ELEVATION: WELL'S STATIC WATER LEVEL 35.06 ft. below land surface measured on mo/day/yr Pump test data: Well water was NA ft. after ... hours pumping ... gpm

5 TYPE OF BLANK CASING USED: 2 PVC CASING JOINTS: Threaded. TYPE OF SCREEN OR PERFORATION MATERIAL: 7 PVC SCREEN OR PERFORATION OPENINGS ARE: 3 Mill slot SCREEN-PERFORATED INTERVALS: From 25 ft to 40 ft GRAVEL PACK INTERVALS:

6 GROUT MATERIAL: 2 Cement grout 3 Bentonite 4 Other Grout Intervals: From 0 ft to 3 ft, From 3 ft to 40 ft What is the nearest source of possible contamination: 14 Abandoned water well

LITHOLOGIC LOG and PLUGGING INTERVALS table with columns FROM, TO, and descriptions of grout materials like Bentonite Chips and Cement Grout.

7 CONTRACTOR'S OR LANDOWNER'S CERTIFICATION: This water well was (1) constructed, (2) reconstructed, or (3) plugged under my jurisdiction and was completed on 7/8/98 and this record is true to the best of my knowledge and belief.