


1 LOCATION OF WATER WELL: County: Pottawatomie	Fraction NE ¼ NE ¼ SE ¼	Section Number 9	Township Number T 10 S	Range Number R 8 E/W
--	-----------------------------------	----------------------------	----------------------------------	--

Distance and direction from nearest town or city street address of well if located within city?
1500 ft NE of 1111 Kretschmer Dr., Manhattan

2 WATER WELL OWNER: **Quaker Oats**
 RR#, St. Address, Box # : **1111 Kretschmer Drive**
 City, State, ZIP Code : **Manhattan, KS 66502**
 Board of Agriculture, Division of Water Resources
 Application Number:

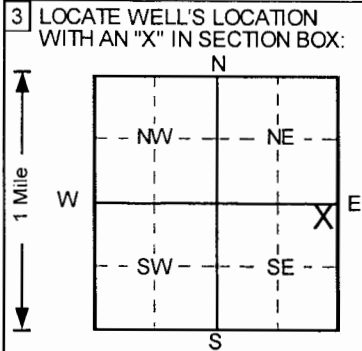

4 DEPTH OF COMPLETED WELL **50** ft. ELEVATION: **0**

Depth(s) Groundwater Encountered 1. ft. 2. ft. 3. ft.

WELL'S STATIC WATER LEVEL . . . **31.43** . . . ft. below land surface measured on mo/day/yr . . . **9/1/2004** . . .

Pump test data: Well water was . . . **NA** . . . ft. after hours pumping gpm

Est. Yield . . **NA** . . . gpm: Well water was ft. after hours pumping gpm

Bore Hole Diameter . . . **8** . . . in. to **50** ft., and in. to ft.

WELL WATER TO BE USED AS: 5 Public water supply 8 Air conditioning 11 Injection well
 1 Domestic 3 Feedlot 6 Oil field water supply 9 Dewatering 12 Other (Specify below)
 2 Irrigation 4 Industrial 7 Lawn and garden only **10** Monitoring well

Was a chemical/bacteriological sample submitted to Department? Yes.....No; If yes, mo/day/yr sample was submitted
 Water Well Disinfected? Yes No

5 TYPE OF BLANK CASING USED:

1 Steel	3 RMP (SR)	5 Wrought iron	8 Concrete tile	CASING JOINTS: Glued Clamped
2 PVC	4 ABS	6 Asbestos-Cement	9 Other (specify below)	Welded
		7 Fiberglass		Threaded. <input checked="" type="checkbox"/>

Blank casing diameter **2** in. to **40** ft., Dia in. to ft., Dia in. to ft.

Casing height above land surface **34.32** in., weight lbs./ft. Wall thickness or gauge No. **Sch. 40**

TYPE OF SCREEN OR PERFORATION MATERIAL

1 Steel	3 Stainless steel	5 Fiberglass	7 PVC	10 Asbestos-cement
2 Brass	4 Galvanized steel	6 Concrete tile	8 RMP (SR)	11 Other (specify)
			9 ABS	12 None used (open hole)

SCREEN OR PERFORATION OPENINGS ARE:

1 Continuous slot	3 Mill slot	5 Gauzed wrapped	8 Saw cut	11 None (open hole)
2 Louvered shutter	4 Key punched	6 Wire wrapped	9 Drilled holes	
		7 Torch cut	10 Other (specify)	

SCREEN-PERFORATED INTERVALS: From **40** ft. to **50** ft., From ft. to ft.

GRAVEL PACK INTERVALS: From **38** ft. to **50** ft., From ft. to ft.

6 GROUT MATERIAL: 1 Neat cement **2** Cement grout **3** Bentonite 4 Other

Grout Intervals: From **2** ft. to **33** ft., From **33** ft. to **38** ft. to ft.

What is the nearest source of possible contamination:

1 Septic tank	4 Lateral lines	7 Pit privy	10 Livestock pens	14 Abandoned water well
2 Sewer lines	5 Cess pool	8 Sewage lagoon	11 Fuel storage	15 Oil well/Gas well
3 Watertight sewer lines	6 Seepage pit	9 Feedyard	12 Fertilizer storage	16 Other (specify below)
			13 Insecticide storage	

Direction from well? How many feet?

FROM	TO	LITHOLOGIC LOG	FROM	TO	PLUGGING INTERVALS
0	15	Silt, Dark Brown to Brown			
15	22	Sands, fine and med. grained,			
22	50.5	Sand, coarse grained, with pebbles,			
					RECEIVED NOV 02 2004 BUREAU OF WATER
					MW5-I, Abovegrade
					Project Name: BM - Quaker Oats
					GeoCore # 1174, #

7 CONTRACTOR'S OR LANDOWNER'S CERTIFICATION: This water well was **(1)** constructed, (2) reconstructed, or (3) plugged under my jurisdiction and was completed on (mo/day/year) **9/1/2004** and this record is true to the best of my knowledge and belief.

Kansas Water Well Contractor's License No. **527** This Water Well Record was completed on (mo/day/yr) **9/1/04** under the business name of **GeoCore, Inc.** by (signature) *Dale Bell*

OFFICE USE ONLY

T

R

EW

SEC

¼

¼

¼