


1 LOCATION OF WATER WELL: County: Pottawatomie Fraction: SW 1/4 NW 1/4 SE 1/4 Section Number: 9 Township Number: T 10 S Range Number: R 8 E/W

Distance and direction from nearest town or city street address of well if located within city? 1111 Kretschmer Drive, Manhattan

2 WATER WELL OWNER: Quaker Oats Food & Beverage Co. 1111 Kretschmer Drive Manhattan, KS 66502 Board of Agriculture, Division of Water Resources Application Number:

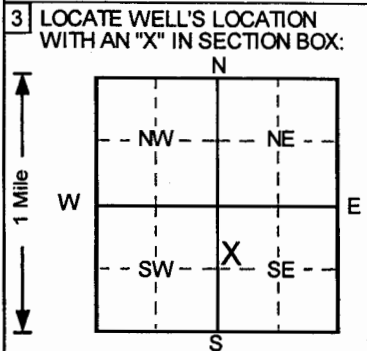

4 DEPTH OF COMPLETED WELL: 20 ft. ELEVATION: 0. Depth(s) Groundwater Encountered 1. ft 2. ft 3. ft. WELL'S STATIC WATER LEVEL: NA ft below land surface measured on mo/day/yr. Pump test data: Well water was NA ft after hours pumping gpm. Est. Yield NA gpm: Well water was ft after hours pumping gpm. Bore Hole Diameter 8 in. to 20 ft, and in. to in. ft. WELL WATER TO BE USED AS: 5 Public water supply 8 Air conditioning 11 Injection well 12 Other (Specify below) Observation well. Was a chemical/bacteriological sample submitted to Department? Yes No. If yes, mo/day/yr sample was submitted Water Well Disinfected? Yes No

5 TYPE OF BLANK CASING USED: 1 Steel 2 PVC 3 RMP (SR) 4 ABS 5 Wrought iron 6 Asbestos-Cement 7 Fiberglass 8 Concrete tile 9 Other (specify below) CASING JOINTS: Glued Clamped Welded Threaded. TYPE OF SCREEN OR PERFORATION MATERIAL: 1 Steel 2 Brass 3 Stainless steel 4 Galvanized steel 5 Fiberglass 6 Concrete tile 7 PVC 8 RMP (SR) 9 ABS 10 Asbestos-cement 11 Other (specify) 12 None used (open hole) SCREEN OR PERFORATION OPENINGS ARE: 1 Continuous slot 2 Louvered shutter 3 Mill slot 4 Key punched 5 Gauzed wrapped 6 Wire wrapped 7 Torch cut 8 Saw cut 9 Drilled holes 11 None (open hole) 10 Other (specify) SCREEN-PERFORATED INTERVALS: From 5 ft to 20 ft, From ft to ft, From ft to ft. GRAVEL PACK INTERVALS: From 4 ft to 20 ft, From ft to ft, From ft to ft.

6 GROUT MATERIAL: 1 Neat cement 2 Cement grout 3 Bentonite 4 Other. Grout Intervals: From 1 ft to 2 ft, From 2 ft to 4 ft, From ft to ft. What is the nearest source of possible contamination: 1 Septic tank 2 Sewer lines 3 Watertight sewer lines 4 Lateral lines 5 Cess pool 6 Seepage pit 7 Pit privy 8 Sewage lagoon 9 Feedyard 10 Livestock pens 11 Fuel storage 12 Fertilizer storage 13 Insecticide storage 14 Abandoned water well 15 Oil well/Gas well 16 Other (specify below). Direction from well? How many feet? 0

Table with columns: FROM, TO, LITHOLOGIC LOG, FROM, TO, PLUGGING INTERVALS. Rows include: 0-12 Silt, tr. plasticity, soft to med., dry to moist, D; 12-20 Silt, med. plasticity, med. to stiff, moist, Brow; OB2, Flushmount; Project Name: BM - Quaker Oats; GeoCore # 1174, #

7 CONTRACTOR'S OR LANDOWNER'S CERTIFICATION: This water well was (1) constructed, (2) reconstructed, or (3) plugged under my jurisdiction and was completed on (mo/day/year) 9/23/2004 and this record is true to the best of my knowledge and belief. Kansas Water Well Contractor's License No. 527. This Water Well Record was completed on (mo/day/yr) 10/22/04 under the business name of GeoCore, Inc. by (signature) Dale Holt