


WATER WELL RECORD Form WWC-5 KSA 82a-1212

1] LOCATION OF WATER WELL:  
 County: **Pottawatomie** Fraction **SW 1/4 NW 1/4 SE 1/4** Section Number **9** Township Number **T 10 S** Range Number **R 8** **E/W**

Distance and direction from nearest town or city street address of well if located within city?  
**1111 Kretschmer Drive, Manhattan**

2] WATER WELL OWNER: **Quaker Oats Food & Beverage Co.**  
 RR#, St. Address, Box # : **1111 Kretschmer Drive**  
 City, State, ZIP Code : **Manhattan, KS 66502**  
 Board of Agriculture, Division of Water Resources  
 Application Number: \_\_\_\_\_

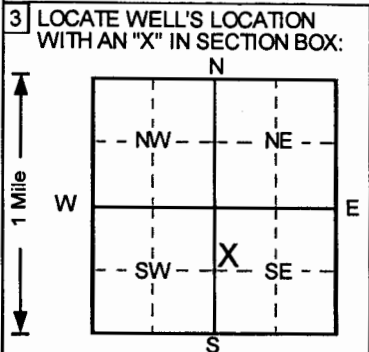

4] DEPTH OF COMPLETED WELL ..... **20** ..... ft ELEVATION: ..... **0** .....  
 Depth(s) Groundwater Encountered 1..... ft 2..... ft 3..... ft  
 WELL'S STATIC WATER LEVEL ..... ft below land surface measured on mo/day/yr .....  
 Pump test data: Well water was **NA** ft after ..... hours pumping ..... gpm  
 Est. Yield **NA** gpm: Well water was ..... ft after ..... hours pumping ..... gpm  
 Bore Hole Diameter **.11** in. to **.20** ft, and..... in. to..... ft  
 WELL WATER TO BE USED AS: 5 Public water supply 8 Air conditioning 11 Injection well  
 1 Domestic 3 Feedlot 6 Oil field water supply 9 Dewatering **12** Other (Specify below)  
 2 Irrigation 4 Industrial 7 Lawn and garden only 10 Monitoring well **Soil vapor extractio**  
 Was a chemical/bacteriological sample submitted to Department? Yes.....No **✓**.....; If yes, mo/day/yr sample was submitted  
 Water Well Disinfected? Yes No **✓**

5] TYPE OF BLANK CASING USED:  
 1 Steel 3 RMP (SR) 5 Wrought iron 8 Concrete tile CASING JOINTS: Glued ..... Clamped .....  
**2** PVC 4 ABS 6 Asbestos-Cement 9 Other (specify below) Welded .....  
 7 Fiberglass ..... Threaded. **✓**  
 Blank casing diameter ..... **4** ..... in. to ..... **8** ..... ft, Dia ..... in. to ..... ft, Dia ..... in. to ..... ft  
 Casing height above land surface ..... **0** ..... in., weight ..... lbs./ft. Wall thickness or gauge No. **Sch. 40**  
 TYPE OF SCREEN OR PERFORATION MATERIAL **7** PVC 10 Asbestos-cement  
 1 Steel 3 Stainless steel 5 Fiberglass 8 RMP (SR) 11 Other (specify) .....  
 2 Brass 4 Galvanized steel 6 Concrete tile 9 ABS 12 None used (open hole)  
 SCREEN OR PERFORATION OPENINGS ARE:  
 1 Continuous slot **3** Mill slot 5 Gauzed wrapped 8 Saw cut 11 None (open hole)  
 2 Louvered shutter 4 Key punched 6 Wire wrapped 9 Drilled holes  
 7 Torch cut 10 Other (specify) .....  
 SCREEN-PERFORATED INTERVALS: From ..... **8** ..... ft to ..... **20** ..... ft, From ..... ft to ..... ft  
 From ..... ft to ..... ft, From ..... ft to ..... ft  
 GRAVEL PACK INTERVALS: From ..... **6** ..... ft to ..... **20** ..... ft, From ..... ft to ..... ft  
 From ..... ft to ..... ft, From ..... ft to ..... ft

6] GROUT MATERIAL: 1 Neat cement 2 Cement grout **3** Bentonite 4 Other .....  
 Grout intervals: From ..... **2** ..... ft to ..... **6** ..... ft, From ..... ft to ..... ft, From ..... ft to ..... ft  
 What is the nearest source of possible contamination:  
 1 Septic tank 4 Lateral lines 7 Pit privy 10 Livestock pens 14 Abandoned water well  
 2 Sewer lines 5 Cess pool 8 Sewage lagoon 11 Fuel storage 15 Oil well/Gas well  
 3 Watertight sewer lines 6 Seepage pit 9 Feedyard 12 Fertilizer storage 16 Other (specify below)  
 13 Insecticide storage .....  
 Direction from well? How many feet? **0**

FROM	TO	LITHOLOGIC LOG	FROM	TO	PLUGGING INTERVALS
0	10.5	Silt, tr. to med. plasticity, med. consistency, Da			
10.5	20	Sand, fine to coarse, Very Pale Brown			
					SVE5, Flushmount
					Project Name: BM - Quaker Oats
					GeoCore # 1174, #

7] CONTRACTOR'S OR LANDOWNER'S CERTIFICATION: This water well was **1** constructed, **2** reconstructed, or **3** plugged under my jurisdiction and was completed on (mo/day/year) ..... **12/6/2004** ..... and this record is true to the best of my knowledge and belief.  
 Kansas Water Well Contractor's License No. .... **527** ..... This Water Well Record was completed on (mo/day/yr) **1/15/05** .....  
 under the business name of **GeoCore, Inc.** by (signature) *Dale Kelly*

OFFICE USE ONLY  
T  
R  
SEC.  
1/4  
1/4