


WATER WELL RECORD Form WWC-5 KSA 82a-1212

1 LOCATION OF WATER WELL: County: Pottawatomie Fraction SW 1/4 NW 1/4 SE 1/4 Section Number 9 Township Number T 10 S Range Number R 8 E/W

Distance and direction from nearest town or city street address of well if located within city? 1111 Kretschmer Drive, Manhattan

2 WATER WELL OWNER: Quaker Oats Food & Beverage Co. 1111 Kretschmer Drive Manhattan, KS 66502 Board of Agriculture, Division of Water Resources Application Number:

3 LOCATE WELL'S LOCATION WITH AN "X" IN SECTION BOX:

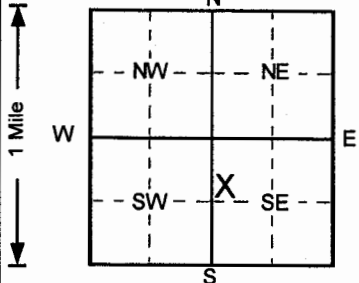

4 DEPTH OF COMPLETED WELL: 20 ft ELEVATION: 0 ft. Depth(s) Groundwater Encountered 1. ... ft. 2. ... ft. 3. ... ft. WELL'S STATIC WATER LEVEL ... ft. below land surface measured on mo/day/yr ... Pump test data: Well water was ... NA ... ft. after ... hours pumping ... gpm Est. Yield ... NA ... gpm: Well water was ... ft. after ... hours pumping ... gpm Bore Hole Diameter ... 11 in. to ... 20 ft., and ... in. to ... ft. WELL WATER TO BE USED AS: 5 Public water supply 8 Air conditioning 11 Injection well 12 Other (Specify below) Soil vapor extraction 1 Domestic 3 Feedlot 6 Oil field water supply 9 Dewatering 2 Irrigation 4 Industrial 7 Lawn and garden only 10 Monitoring Was a chemical/bacteriological sample submitted to Department? Yes ... No [checked] If yes, mo/day/yr sample was submitted Water Well Disinfected? Yes No [checked]

5 TYPE OF BLANK CASING USED: 1 Steel 2 PVC 3 RMP (SR) 4 ABS 5 Wrought iron 6 Asbestos-Cement 7 Fiberglass 8 Concrete tile 9 Other (specify below) CASING JOINTS: Glued ... Clamped ... Welded ... Threaded [checked] Blank casing diameter ... 4 in. to ... 5 ft., Dia ... in. to ... ft., Dia ... in. to ... ft. Casing height above land surface ... 0 in., weight ... lbs./ft. Wall thickness or gauge No. ... Sch. 40 TYPE OF SCREEN OR PERFORATION MATERIAL: 1 Steel 2 Brass 3 Stainless steel 4 Galvanized steel 5 Fiberglass 6 Concrete tile 7 PVC 8 RMP (SR) 9 ABS 10 Asbestos-cement 11 Other (specify) 12 None used (open hole) SCREEN OR PERFORATION OPENINGS ARE: 1 Continuous slot 2 Louvered shutter 3 Mill slot 4 Key punched 5 Gauzed wrapped 6 Wire wrapped 7 Torch cut 8 Saw cut 9 Drilled holes 11 None (open hole) SCREEN-PERFORATED INTERVALS: From ... 5 ft. to ... 20 ft., From ... ft. to ... ft. GRAVEL PACK INTERVALS: From ... 4 ft. to ... 20 ft., From ... ft. to ... ft.

6 GROUT MATERIAL: 1 Neat cement 2 Cement grout 3 Bentonite 4 Other Grout Intervals: From ... 2 ft. to ... 4 ft., From ... ft. to ... ft.

What is the nearest source of possible contamination: 1 Septic tank 2 Sewer lines 3 Watertight sewer lines 4 Lateral lines 5 Cess pool 6 Seepage pit 7 Pit privy 8 Sewage lagoon 9 Feedyard 10 Livestock pens 11 Fuel storage 12 Fertilizer storage 13 Insecticide storage 14 Abandoned water well 15 Oil well/Gas well 16 Other (specify below) Direction from well? How many feet? 0

Table with columns: FROM, TO, LITHOLOGIC LOG, FROM, TO, PLUGGING INTERVALS. Row 1: FROM 0 TO 7, Silt and Clays, tr. plasticity, soft, dry to moist, FROM TO, PLUGGING INTERVALS. Row 2: FROM 7 TO 20, Sands, silty, fine to med., poorly sorted, Dark, FROM TO, PLUGGING INTERVALS.

7 CONTRACTOR'S OR LANDOWNER'S CERTIFICATION: This water well was (1) constructed, (2) reconstructed, or (3) plugged under my jurisdiction and was completed on (mo/day/year) 12/6/2004 and this record is true to the best of my knowledge and belief. Kansas Water Well Contractor's License No. 527 This Water Well Record was completed on (mo/day/yr) 5/5/05 under the business name of GeoCore, Inc. by (signature) Dan [signature]

INSTRUCTIONS: Use typewriter or ball point pen. PLEASE PRESS FIRMLY and PRINT clearly. Please fill in blanks, underline or circle the correct answers. Send top three copies to Kansas Department of Health and Environment, Bureau of Water, Topeka, Kansas 66620-0001. Telephone: 913-296-5545. Send one to WATER WELL OWNER and retain one for your records.