


1 LOCATION OF WATER WELL:	Fraction	Section Number	Township Number	Range Number
County: <u>Riley</u>	<u>SE 1/4 SE 1/4 SE 1/4</u>	<u>07</u>	<u>10 S</u>	<u>08</u> EW

Distance and direction from nearest town or city street address of well if located within city?
Located in drainage ditch south.

2 WATER WELL OWNER:	<u>City of Manhattan, Kansas</u> <u>1101 Paynter</u> <u>Manhattan, KS 66502</u>
RR #, St. Address, Box #: City, State, ZIP Code :	Board of Agriculture, Division of Water Resources Application Number:

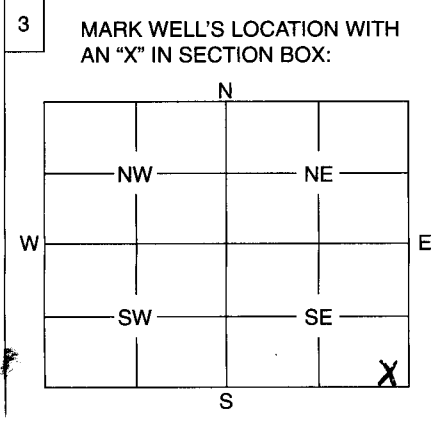

4 DEPTH OF WELL 10 ft.
 WELL'S STATIC WATER LEVEL 0 ft.

WELL WAS USED AS:

1 Domestic	5 Public Water Supply	9 Dewatering
2 Irrigation	6 Oil Field Water Supply	10 Monitoring Well
3 Feedlot	7 Domestic (Lawn & Garden)	11 Injection Well
4 Industrial	8 Air Conditioning	12 Other <u>Unknown</u>

Was a chemical / bacteriological sample submitted to Department? Yes No X

If yes, mo/day/yr sample was submitted

Water Well Disinfected: Yes No X

5 TYPE OF BLANK CASING USED:

<u>1</u> Steel	3 RMP (SR)	5 Wrought	7 Fiberglass	9 Other (Specify below)
2 PVC	4 ABS	6 Asbestos-Cement	8 Concrete Tile	

Blank casing diameter 10 in. Was casing pulled? Yes No X If yes, how much

Casing height above or below land surface 36 in.

6 GROUT PLUG MATERIAL: 1 Neat cement 2 Cement grout 3 Bentonite 4 Other

Grout Plug Intervals: From 10 ft. to 3 ft., From ft. to ft., From to ft.

What is the nearest source of possible contamination:

1 Septic tank	6 Seepage pit	<u>11</u> Fuel storage	16 Other (specify below)
2 Sewer lines	7 Pit privy	12 Fertilizer storage	
3 Watertight sewer lines	8 Sewage lagoon	13 Insecticide storage	
4 Lateral lines	9 Feedyard	14 Abandoned water well	
5 Cess pool	10 Livestock pens	15 Oil well/Gas well	

Direction from well? S/SW How many feet? 1/4 mile

FROM	TO	PLUGGING MATERIALS
<u>10</u>	<u>3</u>	<u>Bentonite</u>
<u>3</u>	<u>0</u>	<u>Compact silts/clays</u>

7 CONTRACTOR'S OF LANDOWNER'S CERTIFICATION: This water well was plugged under my jurisdiction and was completed on (mo/day/year) 04/18/05 and this record is true to the best of my knowledge and belief. Kansas Water Well Contractor's License No. This Water Well Record was completed on (mo/day/year) under the business name of Associated Environmental, Inc. by (signature) [Signature]

INSTRUCTIONS: Use typewriter or ball point pen. Please press firmly and print clearly. Please fill in blanks, underline or circle the correct answers. Send top three copies to Kansas Department of Health and Environment, Bureau of Water, Geology Section, 1000 SW Jackson St., Ste. 420, Topeka, Kansas 66612-1367. Telephone: 785/296-5522. Send one to Water Well Owner and retain one for your records.



ASSOCIATED ENVIRONMENTAL, INC.

404 Pottawatomie, Manhattan, Kansas 66502

Phone (785) 776-7755 * Fax (785) 776-0803

April 26, 2005

Richard Harper
Kansas Department of Health and Environment
1000 SW Jackson, Ste. 420
Topeka, Kansas 66612-1367

RE: Water Well abandonment

Dear Mr. Harper:

Please find enclosed a completed WWC-5P record for the "well" I visited with you about being located in a drainage ditch near the Lime ponds in Manhattan. We could not pull the casing and it did not look like any type of well. The City had no knowledge of any City or homestead well being located there. The pipe thickness appeared to be about 1/4 - inch. The "well" was filled with bentonite and cut off 3-foot below ground surface then finished with compacted silts and clays. I filled out an abandonment form even though this may not have been a well.

If you have any questions or need further clarification or information, please contact me at 785/776-7755.

Sincerely,


Bradley J. Johnson PG
President