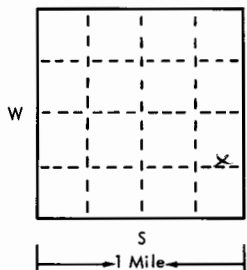
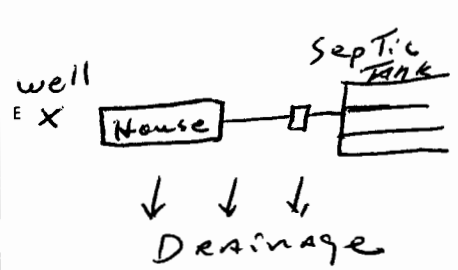


USE TYPEWRITER OR BALL POINT PEN—PRESS FIRMLY, PRINT CLEARLY.

T R EW sec 1/4 1/4 1/4 No.

WATER WELL RECORD  
KSA 82a-1201-1215

Kansas State Dept. Of Health  
(Water Well Contractors)  
Forbes-Bldg. 740  
Topeka, Kansas 66620

1 Location of well:	County: <u>Pottawatomie</u>	Township name: <u>Blue</u>	Fraction: <u>NE 1/4 NE 1/4</u>	Section number: <u>10</u>	Town number: <u>10</u>	Range number: <u>8</u>	
Distance and direction from nearest town or city: <u>3 E - 1/4 S</u>			3 Owner of well: <u>Jay Stephenson</u>				
Street address of well location if in city: <u>MANHATTAN, KS</u>			Address: <u>RT 1 ST. GEO., KANSAS</u>				
Locate with "X" in section below: N 			Sketch map: 			4 Well depth: <u>50</u> ft. Date of completion: <u>2-4-75</u> Well diameter: <u>10</u> in.	
2 Type and color of material			From To		5 <input type="checkbox"/> Cable tool <input checked="" type="checkbox"/> Rotary <input type="checkbox"/> Driven <input type="checkbox"/> Dug <input type="checkbox"/> Hollow rod <input type="checkbox"/> Jetted <input type="checkbox"/> Bored <input type="checkbox"/> Reverse rotary		
					6 Use: <input checked="" type="checkbox"/> Domestic <input type="checkbox"/> Public supply <input type="checkbox"/> Industry <input type="checkbox"/> Irrigation <input type="checkbox"/> Air conditioning <input type="checkbox"/> Commercial <input type="checkbox"/> Test well		
Top Soil			0 5		7 Casing: Material <u>PVC</u> Height: above/below Threaded <input type="checkbox"/> Welded <input type="checkbox"/> Surface <u>24</u> in. Diam. _____ Weight <u>2.33</u> lbs./ft. — <u>0</u> in. to <u>50</u> ft. depth Drive shoe? <input type="checkbox"/> Yes <input checked="" type="checkbox"/> No _____ in. to _____ ft. depth		
Brown Clay			5 20		8 Screen: Manufacturer <u>Pump Co</u> Type <u>PVC</u> Dia. <u>5"</u> Slot/gauge <u>1080</u> Length <u>5'</u> Set between <u>45</u> ft. and <u>50</u> ft. Fittings: Gravel pack <input checked="" type="checkbox"/> Yes <input type="checkbox"/> No Size range of material: <u>1/4" 1/8"</u>		
Fine Sand			20 20		9 Static water level: <u>25</u> ft. below land surface Date <u>2-4-75</u>		
Blue Clay			20 40		10 Pumping level below land surfaces: <u>Air Test</u> _____ ft. after _____ hrs. pumping _____ g.p.m. _____ ft. after _____ hrs. pumping _____ g.p.m. Estimated maximum yield <u>30</u> g.p.m.		
COARSE SAND - GRAVEL			40 50		11 Water sample submitted: <input type="checkbox"/> Yes <input checked="" type="checkbox"/> No Date _____		
					12 Well head completion: <u>Capped</u> <input type="checkbox"/> Pitless adapter <input type="checkbox"/> Inches above grade		
					13 Well grouted? <input checked="" type="checkbox"/> Yes <input type="checkbox"/> No <input checked="" type="checkbox"/> Neat cement <input type="checkbox"/> Bentonite <input type="checkbox"/> _____ Depth: From <u>2</u> ft. to <u>10</u> ft.		
					14 Nearest source of possible contamination: ft. <u>100</u> Direction <u>East</u> Type <u>S. Tank</u> Well disinfected upon completion? <input checked="" type="checkbox"/> Yes <input type="checkbox"/> No		
					15 Pump: <input checked="" type="checkbox"/> Not installed Manufacturer's name _____ Model number _____ HP _____ Volts _____ Length of drop pipe _____ ft. capacity _____ g.p.m. Type: <input type="checkbox"/> Submersible <input type="checkbox"/> Turbine <input type="checkbox"/> Jet <input type="checkbox"/> Reciprocating <input type="checkbox"/> Centrifugal <input type="checkbox"/> Other		
16 Remarks: elevation <u>1010</u> <u>Well slab install by owner</u>					17 Water well contractor's certification: This well was drilled under my jurisdiction and this report is true to the best of my knowledge and belief. <u>STANDER DRILLING CO INC 182</u> Business name _____ License No. _____ Address <u>RT 1 MANHATTAN, KS</u> Signed <u>Dale Carson</u> Date <u>2-5-75</u> Authorized representative		

10 8 E 5 E 1/4 NE SE