

USE TYPEWRITER OR BALL POINT PEN—PRESS FIRMLY, PRINT CLEARLY.


T R EW sec 1/4 1/4 1/4 No.

WATER WELL RECORD  
KSA 82a-1201-1215

Kansas State Dept. Of Health  
(Water Well Contractors)  
Forbes-Bldg. 740  
Topeka, Kansas 66620

1 Location of well: County PATTAWATONIE Township name Blue Fraction NE 1/4 NE 1/4 Section number 10 Town number 10 Range number 8

Distance and direction from nearest town or city: 3 E - 1/4 S 3 Owner of well: Ray Stephenson  
Street address of well location if in city: Manhattan, K's. Address: RT 1 St. Geo., Kansas

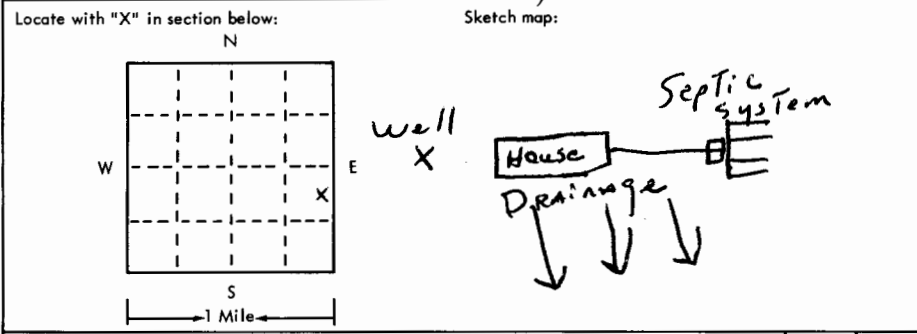

4 Well depth: 50 ft. Date of completion 12-2-75  
Well diameter 10 in.

5  Cable tool  Rotary  Driven  Dug  
 Hollow rod  Jetted  Bored  Reverse rotary

6 Use:  Domestic  Public supply  Industry  
 Irrigation  Air conditioning  Commercial  
 Test well  \_\_\_\_\_

7 Casing: Material PVC Height: above/below  
Threaded  Welded  Surface 24 in.  
Diam. Weight 2.33 lbs./ft.  
5 in. to 50 ft. depth Drive shoe?  Yes  No  
\_\_\_\_ in. to \_\_\_\_ ft. depth

2	Type and color of material	From	To
	Top Soil	0	4
	Brown clay	4	18
	COARSE SAND	18	30
	Blue clay	30	37
	COARSE SAND - <del>CLAY</del>	37	41
	COARSE sand & GRAVEL	41	50

8 Screen: Manufacturer Pump Co  
Type PVC Dia. 5"  
Slot/gauge .080 Length 4'  
Set between 46 ft. and 50 ft.  
Fittings: Gravel pack  Yes  No Size range of material 1/4 x 1/8

9 Static water level: 24 ft. below land surface Date 12-2-75

10 Pumping level below land surfaces: Air Test  
\_\_\_\_ ft. after \_\_\_\_ hrs. pumping \_\_\_\_ g.p.m.  
\_\_\_\_ ft. after \_\_\_\_ hrs. pumping \_\_\_\_ g.p.m.  
Estimated maximum yield 20 g.p.m.

11 Water sample submitted:  Yes  No Date \_\_\_\_\_

12 Well head completion: Capped  
 Pitless adapter  Inches above grade

13 Well grouted?  Yes  No  
 Neat cement  Bentonite  MNC  
Depth: From 0 ft. to 10 ft.

14 Nearest source of possible contamination: MNC 200 ft. Direction W Type S. Tank  
Well disinfected upon completion?  Yes  No

15 Pump:  Not installed  
Manufacturer's name \_\_\_\_\_  
Model number \_\_\_\_\_ HP \_\_\_\_\_ Volts \_\_\_\_\_  
Length of drop pipe \_\_\_\_\_ ft. capacity \_\_\_\_\_ g.m.p.  
Type:  
 Submersible  Turbine  
 Jet  Reciprocating  
 Centrifugal  Other

16 Remarks: elevation 1010 Owner will install well slab

Topography:  
 Hill  
 Slope  
 Upland  
 Valley

17 Water well contractor's certification:  
This well was drilled under my jurisdiction and this report is true to the best of my knowledge and belief.  
Stander Dalg Co. Inc 182  
Business name License No. \_\_\_\_\_  
Address RT 1 Holton, Kansas  
Signed Dale Gibson Date 12-3-75  
Authorized representative

10 8E 5 E 1/2 NE SE